


Give All Information Completely
Make Required Affidavit
Mail or Deliver Report to:
Conservation Division
State Corporation Commission
800 Bittling Building
Wichita, Kansas

WELL PLUGGING RECORD 15-155-19119-0000

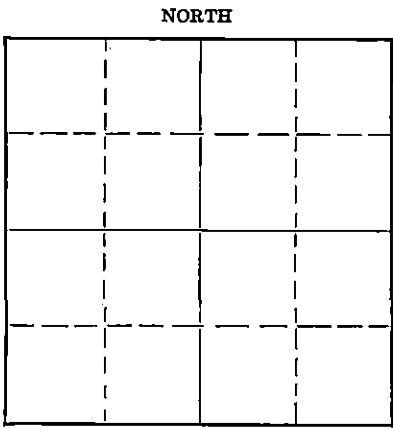

Locate well correctly on above Section Plat

Reno County. Sec. 21 Twp 26S Rge. 9 (E. W. (W))
Location as "NE/CNW 1/4 SW 1/4" or footage from lines 330' fr. NL. & 990' fr. EL.
Lease Owner Phillips Petroleum Company
Lease Name Wyman Well No. 1
Office Address Box 779, Great Bend, Kansas
Character of Well (completed as Oil, Gas or Dry Hole) Oil
Date well completed 2-17-44 19
Application for plugging filed 6-21-51 19
Application for plugging approved 6-22-51 19
Plugging commenced 6-24-51 19
Plugging completed 6-29-51 19
Reason for abandonment of well or producing formation Uneconomical to operate
If a producing well is abandoned, date of last production 12-13-50 19
Was permission obtained from the Conservation Division or its agents before plugging was commenced? Yes

Name of Conservation Agent who supervised plugging of this well Eldon Petty
Producing formation Viola Lime Depth to top 4177 Bottom - Total Depth of Well 4188 Feet
Show depth and thickness of all water, oil and gas formations.

OIL, GAS OR WATER RECORDS

CASING RECORD

Formation	Content	From	To	Size	Put In	Pulled Out
Viola Lime	Oil	4177'	-	8 5/8"	399'	- "
				5 1/2"	4177'	3329'

Describe in detail the manner in which the well was plugged, indicating where the mud fluid was placed and the method or methods used in introducing it into the hole. If cement or other plugs were used, state the character of same and depth placed, from _____ feet to _____ feet for each plug set.

Plugged back with rock and 6 sacks cement from 4188-4170'.
Mudded hole 4170' to 300'. Dumped 15 sacks cement 300' to 270'. Mudded hole from 270' to 30'. Dumped 10 sacks cement 30' to surface. Well plugged and abandoned at 4:00 PM 6-29-51.

RECEIVED
STATE CORPORATION COMMISSION
JUL - 3 1951 7-3-51
CONSERVATION DIVISION
Wichita, Kansas

(If additional description is necessary, use BACK of this sheet)

Correspondence regarding this well should be addressed to Phillips Petroleum Company
Address Box 779
Great Bend, Kansas

STATE OF KANSAS, COUNTY OF BARTON, ss.
A. J. Willis (employee of owner) or (owner) of the above-described well,
being first duly sworn on oath, says: That I have knowledge of the facts, statements, and matters herein contained and the log of the above-described well as filed and that the same are true and correct. So help me God.

(Signature) *A. J. Willis*
Box 779, Great Bend, Kansas
(Address)

SUBSCRIBED AND SWORN TO before me this 2nd day of July, 19 51

Joseph M. Beal
Notary Public.

My commission expires November 18, 1953

PLUGGING
FILE SEC 21 T 26 R 9 Q
BOOK PAGE 89 LINE 43

Formation Record

Lease **Wyman**

Well No. **1**

FROM	TO	Formation	REMARKS
0	235	Sand	
235	390	Red bed	
390	405	Anhydrite	
405	875	Red bed, shale, sand	
875	1050	Shale and shells	
1050	1225	Salt and shale	
1225	1360	Lime and shale	
1360	1380	Lime	
1380	1460	Lime and shale	
1460	1595	Shale and shells	
1595	1850	Broken lime	
1850	1930	Shale, lime, shells	
1930	1980	Lime and shale.	
1980	2065	Shale and shells	
2065	2185	Shale and lime	
2185	2400	Shale and shells	
2400	2420	Shale	
2420	2530	Shale and lime shells	
2530	2575	Broken lime	
2575	3075	Lime and shale	
3075	3205	Lime	
3205	3230	Shale and lime	
3230	3310	Briken lime	
3310	3340	Lime and shale	
3340	3380	Shale	
3380	3641	Lime	Top LKC 3390*
3641	3656	Chert	
3656	3845	Lime	
3845	3917	Lime and shale	
3917	3969	Chert	
3969	3973:	Shale	
3973	4015	Shale and lime	
4015	4105	Shale	
4105	4121	Shale and lime	
4121	4178	Shale	Top Viola 4177* D.F.
4178	4188	Lime	

15-155-19119-0000

Top LKC 3390*

Top Viola 4177* D.F.

RECEIVED
STATE CORPORATION COMMISSION

JUL - 3 1951

CONSERVATION DIVISION
Wichita, Kansas

PLUGGING
FILE SEC 21T-26R-9W
BOOK PAGE 89 LINE 43