

STATE OF KANSAS
STATE CORPORATION COMMISSION


Form CP-4

Give All Information Completely
Make Required Affidavit
Mail or Deliver Report to:
Conservation Division
State Corporation Commission
212 No. Market
Wichita, Kansas

WELL PLUGGING RECORD

15-155-19117-0000

NORTH

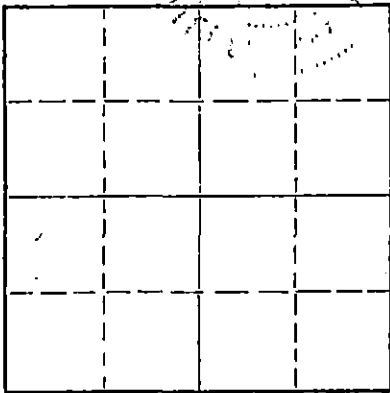

Locate well correctly on above
Section Plat

Range 21 County Sec. 21 Twp. 26 Rge. 9W (E) (W) X
Location as "NE/CNWSW" or footage from lines E/2 E/2 NW/4
Lease Owner Messman-Rinehart Oil Co.
Lease Name Saylor Well No. #1
Office Address 1432 Wichita Plaza, Wichita, Kansas
Character of Well (completed as Oil, Gas or Dry Hole) _____
Date well completed _____ 19____
Application for plugging filed _____ 19____
Application for plugging approved _____ 19____
Plugging commenced 12-12-68 _____ 19____
Plugging completed 12-14-68 _____ 19____
Reason for abandonment of well or producing formation _____

If a producing well is abandoned, date of last production _____ 19____
Was permission obtained from the Conservation Division or its agents before plugging was commenced? _____

Name of Conservation Agent who supervised plugging of this well Gilbert Toman
Producing formation _____ Depth to top _____ Bottom _____ Total Depth of Well 4176' Feet
Show depth and thickness of all water, oil and gas formations.

OIL, GAS OR WATER RECORDS

CASING RECORD

FORMATION	CONTENT	FROM	TO	SIZE	PUT IN	PULLED OUT
				5 1/2"	4174'	2213.94'
				8 5/8"	283'	

Describe in detail the manner in which the well was plugged, indicating where the mud fluid was placed and the method or methods used in introducing it into the hole. If cement or other plugs were used, state the character of same and depth placed, from _____ feet to _____ feet for each plug set.

Made bottom hole plug back with sand to 3795'. Mixed and ran 5 sacks cement thru dump bailer.
Mudded hole to 280', set 10' rock bridge. Mixed and ran 25 sacks cement thru dump bailer. Mudded hole to 40', set 10' rock bridge. Mixed and ran 10 sacks cement to base of cellar.

RECEIVED
STATE CORPORATION COMMISSION
DEC 18 1968
CONSERVATION DIVISION
Wichita, Kansas

(If additional description is necessary, use BACK of this sheet)


Name of Plugging Contractor Southwest Casing Pulling Co.
Address Box 364, Great Bend, Kansas

STATE OF Kansas, COUNTY OF Barton, ss.
Southwest Casing Pulling Co. (employee of owner) or (owner or operator) of the above-described well, being first duly sworn on oath, says: That I have knowledge of the facts, statements, and matters herein contained and the log of the above-described well as filed and that the same are true and correct. So help me God.

(Signature) W. C. Spencer Sec.
Box 364, Great Bend, Kansas
(Address)

SUBSCRIBED AND SWORN to before me this 16 day of December, 19 68

My commission expires October 1972

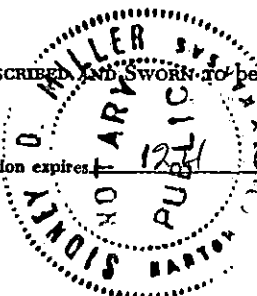

Sidney D. Miller
Notary Public.

DRILLER'S LOG

15-155-19117-0000

Company: Halliburton Oil Producing Company, Oklahoma City, Oklahoma
Contractor: Shawver-Armour, Inc., Wichita, Kansas
Lease: Saylor # 1
Location: E/2 E/2 NW 21-26S-9W, Reno County, Kansas
Commenced: 9-13-58
Completed: 9-26-58
Casing: Set 8 5/8" @ 280' with 250 sacks cement

0-100	Sand
100-160	Sand, Clay
160-280	Red Bed
280-1045	Red Bed, salt, shale
1045-1295	Shale
1295-1434	Anhydrite, chalky lime
1434-1561	Lime, shale
1561-1660	Shale, lime, shells
1660-1675	Lime, shale streaks
1675-1740	Shale
1740-1850	Ft. Riley Lime 1740, shale
1850-2000	Ft. Riley lime, shale
2000-2160	Shale, lime streaks
2160-2660	Lime, shale
2660-2780	Sandy shale
2780-3390	Shale, lime
3390-3394	Shale, K.C. Lime 3394
3394-3795	K.C. Lime, shale
3795-3906	Lime, shale
3906-3922	Miss. lime, chert
3922-3976	Miss. lime
3976-4005	Lime, shale
4005-4020	Lime, shale
4020-4035	Kinderhook @ 4035
4035-4176	Shale, lime V. Lime @ 4176, T.D.

RECEIVED
STATE CORPORATION COMMISSION
JAN 22 1969
CONSERVATION DIVISION
Wichita, Kansas

Set 5 1/2" casing @ 4174', cemented with 250 sacks of cement

I, D. D. Swearingen, do hereby certify that the above and foregoing is a true and correct copy of the log of the # 1 Saylor, located in the E/2 E/2 NW 21-26S-9W, Reno County, Kansas, as reflected by the Daily Drilling Report of Shawver-Armour, Inc.

Halliburton Oil Producing Company

By D. D. Swearingen
D. D. Swearingen

Subscribed and sworn to before me, a Notary Public, in and for Oklahoma County, Oklahoma, this 4th day of December, 1968

My Commission expires 4-15-70

Margaret Landersley
Notary Public