


STATE OF KANSAS
STATE CORPORATION COMMISSION

Give All Information Completely
Make Required Affidavit
Mail or Deliver Report to:
Conservation Division
State Corporation Commission
800 Bitting Building
Wichita, Kansas

WELL PLUGGING RECORD

Sedgwick County. Sec. 26 Twp. 25 Rge. 1 (NE) (W)
Location as "NE/CNW/SW" or footage from lines NE NE SE
Lease Owner Charles L. Carlock
Lease Name Updegraff Well No. 1
Office Address 102 Insurance Bldg.
Character of Well (completed as Oil, Gas or Dry Hole) Dry Hole
Date well completed September 1955
Application for plugging filed " 1955
Application for plugging approved " 1955
Plugging commenced " 1955
Plugging completed " 1955
Reason for abandonment of well or producing formation Dry Hole

NORTH

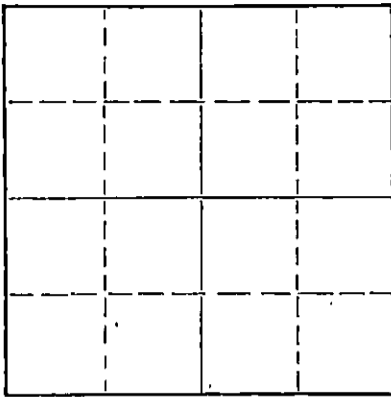

Locate well correctly on above
Section Plat

If a producing well is abandoned, date of last production 19
Was permission obtained from the Conservation Division or its agents before plugging was commenced? Yes

Name of Conservation Agent who supervised plugging of this well Ruel Durkee, Box 597, McPherson, Ks.
Producing formation _____ Depth to top _____ Bottom _____ Total Depth of Well _____ Feet
Show depth and thickness of all water, oil and gas formations.

OIL, GAS OR WATER RECORDS

CASING RECORD

FORMATION	CONTENT	FROM	TO	SIZE	PUT IN	PULLED OUT
				8-5/8"	147.13'	None

Describe in detail the manner in which the well was plugged, indicating where the mud fluid was placed and the method or methods used in introducing it into the hole. If cement or other plugs were used, state the character of same and depth placed, from _____ feet to _____ feet for each plug set.

Rotary mud to bottom of surface pipe - 137 ft., built solid 15 ft. bridge. Cemented w/15 sacks cement through drill pipe.
Rotary mud to 30 ft. of top cemented w/10 sack cap.

RECEIVED
STATE CORPORATION COMMISSION
9-29-55 SEP 29 1955
CONSERVATION DIVISION
Wichita, Kansas

(If additional description is necessary, use BACK of this sheet)
Name of Plugging Contractor Bedell-Catt Drilling Co., Inc.
Address 605 Union National Bank Bldg., Wichita 2, Kansas

STATE OF Kansas, COUNTY OF Sedgwick, ss.
Corb S. Bedell (employee of owner) or (owner or operator) of the above-described well, being first duly sworn on oath, says: That I have knowledge of the facts, statements, and matters herein contained and the log of the above-described well as filed and that the same are true and correct. So help me God.

(Signature) BEDELL-CATT DRILLING CO., INC.
By: Corb S. Bedell (Address)

SUBSCRIBED AND SWORN to before me this 28th day of September, 19 55

Frances L. Webber
Notary Public.

My commission expires March 18, 1958

PLUGGING
SEC 26 T 25 R 14
BOOK PAGE 149 LINE 18

DRILLING LOG

Company: Charles L. Carlock
102 Insurance Bldg.
Wichita, Kansas

Lease: Updegraff

Well: #1

Location: NE 1/4 NE 1/4 of Section 26, Township 25, Range 1 West,
Sedgwick County, Kansas

Contractor: Bedell-Catt Drilling Co., Inc.
605 Union National Bank Bldg.
Wichita 2, Kansas

Date Comm.: September 3, 1955

Date Comp.: September 13, 1955

T. D. 3210'

Production: D & A

Casing: 8-5/8" to 147.13'

Figures Indicate the Bottom of Formation

0-137	Sand & lime
201	Lime & shale & sand
294	Shale & shells
2452	Shale & lime
2815	Lime
3135	Shale & lime
3147	Lime & chard
3191	Shale & lime
3210	Lime & Dolomite

I certify the above to be true and correct to the best of my knowledge and belief.

BEDELL-CATT DRILLING CO., INC.

By Carl S. Bedell

Subscribed and sworn before me this 27th day of September, 1955.

Charles L. Webber
Notary Public

My Commission Expires:

March 18, 1958

PLUGGING
SEC. 26 T. 25 R. 1W
BOOK PAGE 149 LINE 12

RECEIVED
STATE CORPORATION COMMISSION
SEP 27 1955
CONSERVATION DIVISION
Wichita, Kansas