


STATE OF KANSAS
STATE CORPORATION COMMISSION

Give All Information Completely
Make Required Affidavit
Mail or Deliver Report to:
Conservation Division
State Corporation Commission
211 No. Broadway
Wichita, Kansas

WELL PLUGGING RECORD

NORTH

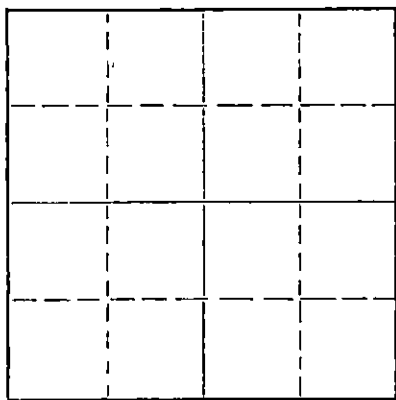

Locate well correctly on above
Section Plat

Sedgwick County, Sec. 26 Twp. 25 Rge. XXXXXX 1 (W)
Location as "NE/CNW/SW" or footage from lines NE NE SE
Lease Owner Aladdin Petroleum Corp.
Lease Name Updegraff Well No. 1
Office Address 809 Petroleum Building, Wichita 2, Kansas
Character of Well (completed as Oil, Gas or Dry Hole) Dry Hole (Washdown)
Date well completed June 12 19 58
Application for plugging filed " 19 58
Application for plugging approved " 19 58
Plugging commenced " 19 58
Plugging completed " 19 58
Reason for abandonment of well or producing formation Dry Hole

If a producing well is abandoned, date of last production 19
Was permission obtained from the Conservation Division or its agents before plugging was commenced? yes

Name of Conservation Agent who supervised plugging of this well Wilbur Martin, Cedar Vale, Kansas
Producing formation Depth to top Bottom Total Depth of Well 3765 Feet
Show depth and thickness of all water, oil and gas formations.

OIL, GAS OR WATER RECORDS

CASING RECORD

FORMATION	CONTENT	FROM	TO	SIZE	PUT IN	PULLED OUT
				8-5/8"	137'	none

Describe in detail the manner in which the well was plugged, indicating where the mud fluid was placed and the method or methods used in introducing it into the hole. If cement or other plugs were used, state the character of same and depth placed, from feet to feet for each plug set.

5 sx cement on bottom. Rock Bridge. Mud to
250 ft. of top. Solid bridge. 10 sx cement
bridge 125 ft. below fresh water. 12 sx cement
Mud to 35 ft. of top. 5 sx cement. Mud to top.
Cut surface 30" below ground.

RECEIVED
STATE OF KANSAS
JUN 19 1958

6-18-58 JUN 19 1958

CONSERVATION DIVISION
Wichita, Kansas

(If additional description is necessary, use BACK of this sheet)

Name of Plugging Contractor Bedell-Catt Drilling Company
Address 701 Petroleum Building, Wichita 2, Kansas

STATE OF Kansas, COUNTY OF Sedgwick, ss.

Corb S. Bedell (employee of owner) or (owner or operator) of the above-described well, being first duly sworn on oath, says: That I have knowledge of the facts, statements, and matters herein contained and the log of the above-described well as filed and that the same are true and correct. So help me God.

(Signature) Bedell-Catt Drilling Company

By: Corb S. Bedell
Corb S. Bedell (Address) Partner

SUBSCRIBED AND SWORN TO before me this 17th day of June, 19 58

Frances L. Webber
Frances L. Webber Notary Public.

My commission expires March 18, 1962

PLUGGING
FILE SEC 26 T. 25 R. 1W
BOOK PAGE 107 LINE 44

DRILLING LOG

Company: Aladdin Petroleum Corp.
809 Petroleum Building
Wichita 2, Kansas
Lease: Updegraff
Well: #1
Location: NE NE SE of Section 26, Township 25, Range 1 West,
Sedgwick County, Kansas
Contractor: Bedell-Catt Drilling Company
701 Petroleum Building
Wichita 2, Kansas
Date Comm: June 6, 1958
Date Comp: June 12, 1958
T. D.: 3765'
Production: D & A (Washdown)
Casing: 8-5/8" to 137'

Figures Indicate the Bottom of Formation

0-137	Surface Hole
3441	Miss. Lime
3525	Lime
3602	Shale
3631	Hunton Lime
3674	Lime
3765	S. Sand
3765	T. D.

I certify the above to be true and correct to the best of
my knowledge and belief.

BEDELL-CATT DRILLING COMPANY

By

Carl S. Bedell
Carl S. Bedell

Subscribed and sworn before me this 17th day of June, 1958.

Frances L. Webber
Notary Public
Frances L. Webber

My Commission Expires:

March 18, 1962

PLUGGING

FILE SEC. 26 T. 25 R. 1W
BOOK PAGE 10.7 LINE 44