


R

STATE OF KANSAS
STATE CORPORATION COMMISSION

Give All Information Completely
Make Required Affidavit
Mail or Deliver Report to:
Conservation Division
State Corporation Commission
212 North Market, Insurance Bldg.
Wichita, Kansas

WELL PLUGGING RECORD

SENEGWICK County. Sec. **25** Twp. **25** Rge. **1** **NE W** (E) (W)

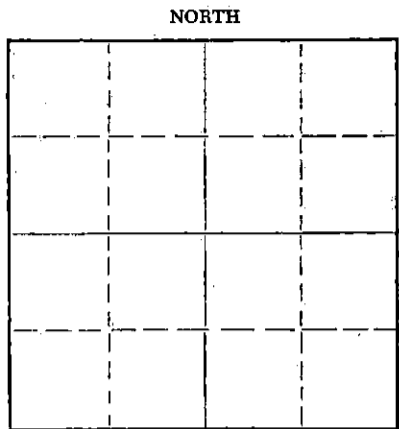

Locate well correctly on above
Section Plat

Location as "NE/CNW/SW" or footage from lines.
Lease Owner **John C. Graves**
Lease Name **MUELLER** Well No. **1**
Office Address **P. O. Box 332, El Dorado, Kansas**
Character of Well (completed as Oil, Gas or Dry Hole) **Dry Hole**
Date well completed **1-30 19 60**
Application for plugging filed **1-30 19 60**
Application for plugging approved **1-30 19 60**
Plugging commenced **1-30 19 60**
Plugging completed **1-30 19 60**
Reason for abandonment of well or producing formation **Dry Hole**

If a producing well is abandoned, date of last production **19**
Was permission obtained from the Conservation Division or its agents before plugging was commenced? **Yes Lee N. Gutarie, Lech, Kansas**

Name of Conservation Agent who supervised plugging of this well
Producing formation _____ Depth to top _____ Bottom _____ Total Depth of Well **3005** Feet
Show depth and thickness of all water, oil and gas formations.

OIL, GAS OR WATER RECORDS

CASING RECORD

FORMATION	CONTENT	FROM	TO	SIZE	PUT IN	PULLED OUT

Describe in detail the manner in which the well was plugged, indicating where the mud fluid was placed and the method or methods used in introducing it into the hole. If cement or other plugs were used, state the character of same and depth placed, from _____ feet to _____ feet for each plug set.

Plugged hole with heavy mud to 240'
Set plug with 1/4 sack hulls - 15 sacks cement
Filled hole to 35' with heavy mud
Set plug with 1/4 sack hulls and 10 car cement to surface
Plugged rat hole with 10 sack cement

RECEIVED
STATE CORPORATION COMMISSION

FEB 10 1960

CONSERVATION DIVISION
Wichita, Kansas

(If additional description is necessary, use BACK of this sheet)

Name of Plugging Contractor _____
Address _____

STATE OF **KANSAS** COUNTY OF **BUTLER**, ss. **John C. Graves**

(employee of owner) or (owner or operator) of the above-described well, being first duly sworn on oath, says: That I have knowledge of the facts, statements, and matters herein contained and the log of the above-described well as filed and that the same are true and correct. So help me God.

(Signature) **John C. Graves**
P. O. Box 332, El Dorado, Kansas

SUBSCRIBED AND SWORN TO before me this **9th** day of **February**, 19 **60**

Nov. 23, 1963
Marlene Fairchild Notary Public.

My commission expires _____



R

Total Depth - 3605' NE-NE-NE
 Contractor - Graves Drilg. Co., Inc. Section 25-25-1W
 Date Commenced - 1-20-60 Sedgwick County, Kansas
 Date Completed - 1-30-60 8 5/8" @ 212'

FORMATION	DEPTH
Surface hole	212
Lime & shale	650
Lime	800
Lime & shale	1075
Shale & Lime strks	1430
Shale & Lime	1645
Sandy Lime & shale	1918
Shale & Lime	2320
Lime (Lansing)	2456
Shale & lime	2593
Lime (KC)	2798
Shale & lime	3067
Lime (Miss)	3128
Lime & shale (Miss. Hard)	3186
Lime (Miss)	3347
Lime	3383
Lime (Miss)	3422
Lime & shale	3437
Shale (Kind)	3525
Shale	3530
Hunton	3571
Viola	3594
Simpson Sand	3605 T.D.

RECEIVED
 STATE CORPORATION COMMISSION
 FEB 11 1960
 CONSERVATION DIVISION
 Wichita

I hereby certify the foregoing statements to be true and correct to the best of my knowledge.

Graves Drilling Company, Inc.

John C. Graves

STATE OF KANSAS }
) SS
 COUNTY OF BUTLER }

Subscribed and sworn to before me, a Notary Public, this 9th day of February, 1960.

My commission expires

Marlene S. Church
 (Notary Public)

November 23, 1963