


STATE OF KANSAS
STATE CORPORATION COMMISSION

WELL PLUGGING RECORD

Give All Information Completely
Make Required Affidavit
Mail or Deliver Report to
Conservation Division
State Corporation Comm.
245 North Water
Wichita, KS 67202

Kiowa County. Sec. 26 Twp. 27 Rge. 19 W^E/_W
Location as "NE/CNW $\frac{1}{2}$ SW $\frac{1}{4}$ " or footage from lines _____
C SW NW

Lease Owner White & Ellis Drilling, Inc.
Lease Name Pyle Well No. 1
Office Address Box 448 - El Dorado, Kansas 67042
Character of Well (Completed as Oil, Gas or Dry Hole) _____
Dry Hole
Date Well completed 4-13 1977
Application for plugging filed 4-13 1977
Application for plugging approved 4-13 1977
Plugging commenced 4-13 1977
Plugging completed 4-13 1977
Reason for abandonment of well or producing formation _____

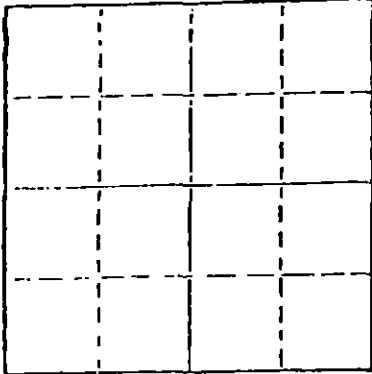

Locate well correctly on above
Section Plat

Dry Hole
If a producing well is abandoned, date of last production _____
19____

Was permission obtained from the Conservation Division or
its agents before plugging was commenced? Yes

Name of Conservation Agent who supervised plugging of this well Jasper H. Metz
Producing formation _____ Depth to top _____ Bottom _____ Total Depth of Well 4860
Show depth and thickness of all water, oil and gas formations.

OIL, GAS OR WATER RECORDS

CASING RECORD

FORMATION	CONTENT	FROM	TO	SIZE	PUT IN	PULLED OUT
				8 5/8"	615'	

Describe in detail the manner in which the well was plugged, indicating where the mud fluid
was placed and the method or methods used in introducing it into the hold. If cement or other
plugs were used, state the character of same and depth placed, from _____ feet to
_____ feet for each plug set.

- 4-13-77 Mud to 600' plugged with 40 sacks of cement.
- 4-13-77 Mud and bridge to 40' plugged with 10 sacks of cement.
- 4-13-77 Plugged rathole with 5 sacks of cement.

REC'D
STATE CORPORATION COMMISSION
JUN 21 1977 6-21-77

CONSERVATION DIVISION
Wichita, Kansas

(If additional description is necessary, use BACK of this sheet)

Name of Plugging Contractor Gabbert - Jones, Inc. & Howco
830 Sutton Place - Wichita, Kansas 67202

STATE OF Kansas COUNTY OF Butler, ss.
Howard E. Russell (employee of owner) or (owner or operator)
of the above-described well, being first duly sworn on oath, says: That I have knowledge of
the facts, statements, and matters herein contained and the log of the above-described well
as filed and that the same are true and correct. So help me God.

(Signature) Howard E. Russell

(Address)

SUBSCRIBED AND SWORN TO before me this 20th day of June, 1977

L. B. Auer Notary Public.

My commission expires _____

IMPORTANT
 Kans. Geo. Survey request
 samples on this well.

KANSAS DRILLERS LOG

S. 26 T. 27 R. 19 ^K_W

API No. 15 — 097 County — 20,388 Number

Loc. C SW NW


Operator
White & Ellis Drilling, Inc.

County Kiowa

Address
Box 448 El Dorado, Kansas 67042

640 Acres
N

Well No. #1 Lease Name Pyle

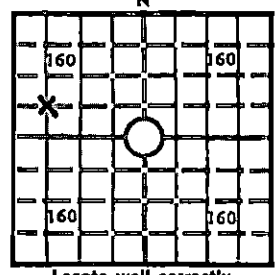

Footage Location
660 feet from ~~XX~~ (S) line 660 feet from ~~XX~~ (W) line

Locate well correctly
Elev.: Gr. 2238

Principal Contractor Gabbert-Jones Geologist Wm. Sladek

Spud Date 3-31-77 Total Depth 4850' P.B.T.D.

Date Completed 4-13-77 Oil Purchaser None

DF 2241 KB 2243

CASING RECORD

Report of all strings set— surface, intermediate, production, etc.

Purpose of string	Size hole drilled	Size casing set (in O.D.)	Weight lbs/ft.	Setting depth	Type cement	Sacks	Type and percent additives
Surface	12½"	8 5/8"	28#	615'	Common	425	3% cc & 2% Gel

LINER RECORD

PERFORATION RECORD

Top, ft.	Bottom, ft.	Sacks cement	Shots per ft.	Size & type	Depth interval

TUBING RECORD

Size	Setting depth	Packer set at

ACID, FRACTURE, SHOT, CEMENT SQUEEZE RECORD

Amount and kind of material used	Depth interval treated

RECEIVED
 STATE CORPORATION COMMISSION
 JUN 21 1977
 CONSERVATION DIVISION
 WICHITA, KANSAS

INITIAL PRODUCTION

Date of first production		Producing method (flowing, pumping, gas lift, etc.)			
RATE OF PRODUCTION PER 24 HOURS	Oil	Gas	Water	Gas-oil ratio	
	bbls.	bbls.	bbls.	MCF	CFPB
Disposition of gas (vented, used on lease or sold)			Producing interval(s)		

INSTRUCTIONS: As provided in KCC Rule 82-2-125, within 90 days after completion of a well, one completed copy of this Drillers Log shall be transmitted to the State Geological Survey of Kansas, 4150 Monroe Street, Wichita, Kansas 67209. Copies of this form are available from the Conservation Division, State Corporation Commission, 3830 So. Meridian (P.O. Box 17027), Wichita, Kansas 66217. Phone AC 316-522-2206. If confidential custody is desired, please note Rule 82-2-125. Drillers Logs will be on open file in the Oil and Gas Division, State Geological Survey of Kansas, Lawrence, Kansas 66044.

Operator
 WHITE & ELLIS DRILLING, INC.

DESIGNATE TYPE OF COMP.: OIL, GAS,
 DRY HOLE, SWDW, ETC.:
 Dry Hole

Well No. 1 Lease Name Pyle

S 26 T 27 R 19 ~~W~~
 W

WELL LOG

Show all important zones of porosity and contents thereof; cored intervals, and all drill-stem tests, including depth interval tested, cushion used, time tool open, flowing and shut-in pressures, and recoveries.

SHOW GEOLOGICAL MARKERS, LOGS RUN,
 OR OTHER DESCRIPTIVE INFORMATION.

FORMATION DESCRIPTION, CONTENTS, ETC.	TOP	BOTTOM	NAME	DEPTH
Sand	0	130		
Sand-Shalē	130	555		
Redbed	555	618		
Anhydrite	618	622		
Redbed-Shale	622	1160		
Shale-Shells	1160	1650		
Shale	1650	2187		
Lime-Shale	2187	2600		
Lime	2600	3400		
Lime-Shale	3400	3820		
Lime	3820	4135		
Lime-Shale	4135	4220		
Lime	4220	4860		
RTD		4860		

USE ADDITIONAL SHEETS, IF NECESSARY, TO COMPLETE WELL RECORD.

Date Received	Signature
	Title
	Date