

AUG 22 1980

15-097-20667-0000

FORM CP-4

STATE OF KANSAS  
STATE CORPORATION COMMISSION


WELL PLUGGING RECORD

Give All Information Completely  
Make Required Affidavit  
Mail or Deliver Report to  
Conservation Division  
State Corporation Comm.  
245 North Water  
Wichita, KS 67202

Kiowa County, Sec. 7 Twp. 27S Rge. 20W E/W  
Location as "NE/CNW $\frac{1}{4}$ SW $\frac{1}{4}$ " or footage from lines  
C SW/4 SE/4

Lease Owner Gear Petroleum Company, Inc.  
Lease Name Einsel "F" Well No. 1  
Office Address 300 Sutton Place, Wichita, Kansas 67202  
Character of Well (Completed as Oil, Gas or Dry Hole) D & A

Date Well completed August 12, 1980  
Application for plugging filed August 12, 1980  
Application for plugging approved August 12, 1980  
Plugging commenced August 12, 1980  
Plugging completed August 12, 1980  
Reason for abandonment of well or producing formation D & A

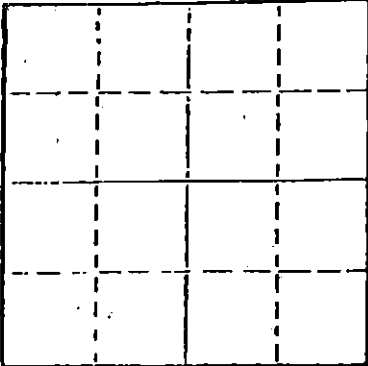

Locate well correctly on above  
Section Plot

If a producing well is abandoned, date of last production 19

Was permission obtained from the Conservation Division or  
its agents before plugging was commenced? Yes

Name of Conservation Agent who supervised plugging of this well Wm. T. Owen  
Producing formation Depth to top Bottom Total Depth of Well 4,895'

Show depth and thickness of all water, oil and gas formations.

OIL, GAS OR WATER RECORDS

CASING RECORD

FORMATION	CONTENT	FROM	TO	SIZE	PUT IN	PULLED OUT
				8 5/8"	524.94'	-0-

Describe in detail the manner in which the well was plugged, indicating where the mud fluid was placed and the method or methods used in introducing it into the hold. If cement or other plugs were used, state the character of same and depth placed, from feet to feet for each plug set.

Plugged hole @ 540' w/50 sx cement  
Mud to 40', hulls, plug & 10 sx cement  
10 sx cement in rathole  
50-50 Pozmix, 4% Gel

9-9-80  
RECEIVED  
STATE CORPORATION COMMISSION  
SEP - 9 1980  
CONSERVATION DIVISION  
Wichita, Kansas

(If additional description is necessary, use BACK of this sheet)


Name of Plugging Contractor Red Tiger Drilling Company  
1720 KSB&T Building, Wichita, Kansas 67202

STATE OF Kansas COUNTY OF Sedgwick  
Gloria Fawcett (employee of contractor)

of the above-described well, being first duly sworn on oath, says: That I have knowledge of the facts, statements, and matters herein contained and the log of the above-described well as filed and that the same are true and correct. So help me God.

(Signature) Gloria Fawcett  
1720 KSB&T Building, Wichita, Kansas 67202  
(Address)

SUBSCRIBED AND SWORN TO before me this 20th day of August, 1980.

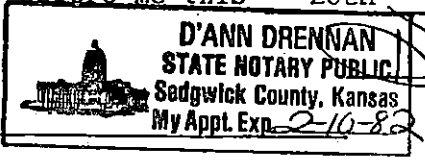

D'Ann Drennan  
Notary Public.

My commission expires

AUG 22 1980

DRILLERS LOG

No. 1 Einsel "F"

CASING RECORD:	COMPANY:	Gear Petroleum Company	DESCRIPTION:
8 5/8" @ 533.34'	CONTRACTOR:	Red Tiger Drilling Company	C SW/4 SE/4
w/275 sx cement	COMMENCED:	August 4, 1980	Sec. 7-T27S-R20W
			Kiowa County, Kansas
D & A	COMPLETED:	August 12, 1980	
TOTAL DEPTH: 4,895'			ELEVATION: 2,285' KB

<u>FORMATION</u>	<u>FROM</u>	<u>TO</u>	<u>REMARKS</u>
Sand	0	83	
Clay & Shale	83	185	
Shale	185	537	
Gray Shale	537	676	
Red Bed	676	740	
Lime & Shale	740	1465	
Shale & Lime	1465	2018	
Shale w/Lime Streaks	2018	2310	
Lime	2310	2500	
Lime & Shale	2500	2715	
Lime	2715	3100	
Shale & Lime	3100	3320	
Lime	3320	3680	
Shale & Lime	3680	3970	
Lime	3970	4185	
Shale w/Lime	4185	4405	
Shale & Lime	4405	4550	
Lime	4550	4825	
Shale & Lime	4825	4880	
Lime	4880	4895	
RTD		4895	

I certify that this is a true and correct copy of the above log to the best of my knowledge.

RED TIGER DRILLING COMPANY

*Gloria Fawcett*  
 \_\_\_\_\_  
 Gloria Fawcett

Subscribed and sworn to before me this 20th day of August, 1980.

*D'Ann Drennan*  
 \_\_\_\_\_  
 Notary Public

