


STATE OF KANSAS
STATE CORPORATION COMMISSION

Give All Information Completely
Make Required Affidavit
Mail or Deliver Report to:
Conservation Division
State Corporation Commission
212 No. Market
Wichita, Kansas

WELL PLUGGING RECORD

KIOWA County. Sec. 35 Twp. 27S Rge. 19W (E) (W)
Location as "NE/CNW/SW" or footage from lines C SE NW
Lease Owner Pickrell Drilling Company
Lease Name Taylor "B" Well No. 1
Office Address 705 4th National Bank Bldg. Wichita, Kansas
Character of Well (completed as Oil, Gas or Dry Hole) Dry Hole
Date well completed November 25, 1968 19
Application for plugging filed November 25, 1968 19
Application for plugging approved November 25, 1968 19
Plugging commenced November 25, 1968 19
Plugging completed November 25, 1968 19
Reason for abandonment of well or producing formation Dry Hole

NORTH

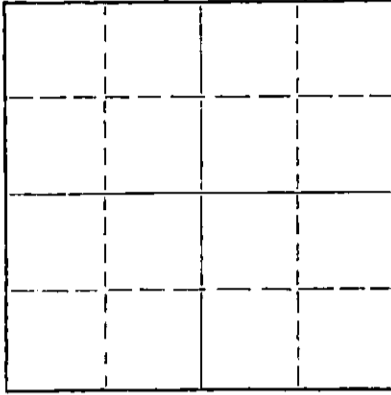

Locate well correctly on above
Section Plat

If a producing well is abandoned, date of last production _____ 19____
Was permission obtained from the Conservation Division or its agents before plugging was commenced? Yes

Name of Conservation Agent who supervised plugging of this well Archie Elving, Pratt, Kansas
Producing formation _____ Depth to top _____ Bottom _____ Total Depth of Well 4975 Feet
Show depth and thickness of all water, oil and gas formations.

OIL, GAS OR WATER RECORDS

CASING RECORD

FORMATION	CONTENT	FROM	TO	SIZE	PUT IN	PULLED OUT
				8 5/8	358'	

Describe in detail the manner in which the well was plugged, indicating where the mud fluid was placed and the method or methods used in introducing it into the hole. If cement or other plugs were used, state the character of same and depth placed, from _____ feet to _____ feet for each plug set.

Heavy mud to 600. Set plug. Cemented with
50 sacks cement. Heavy mud to 300'. Set plug
Cemented with 25 sacks. Heavy mud to 40'. cemented
with 10 sacks to bottom of cellar. Plugged rat
hole with 2 sacks of cement.

RECEIVED
STATE CORPORATION COMMISSION
DEC 10 1968
CONSERVATION DIVISION
Wichita, Kansas

(If additional description is necessary, use BACK of this sheet)
Name of Plugging Contractor Pickrell Drilling Company
Address 705 4th National Bank Building, Wichita 2, Kansas

STATE OF Kansas, COUNTY OF Sedgwick, ss.


_____ (employee of owner) or (owner or operator) of the above-described well, being first sworn on oath, says: That I have knowledge of the facts, statements and matters herein contained and the log of the above-described well and that the same are true and correct. So help me God.

(Signature) C. W. Sebitts
705 4th National Bank Bldg, Wichita 2, Ks. (Address)

Subscribed and sworn to before me this 4th day of December, 19 68

My commission expires May 10, 1970

L. M. Whiting
L. M. Whiting Notary Public.

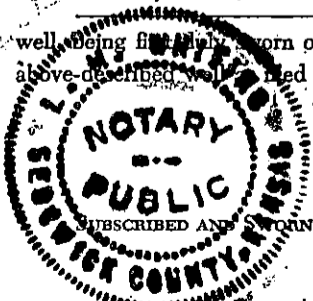

ROTARY DRILLING LOG

COMPANY: PICKRELL DRILLING COMPANY
 705 4th National Bank Bldg.
 Wichita, Kansas
 LOCATION: C SE NW Sec. 35-27S-19W, Kiowa County,
 Kansas, Taylor "B"

Rotary Drilling Commenced 11-13-68
 Rotary Drilling Completed 11-25-68

CONTRACTOR: **PICKRELL DRILLING COMPANY**
Wichita, Kansas

CASING RECORD: Ran 21 jts. used 28# casing set at 358' KB. Cemented with 300 sacks cement. Circulated 11:35, November 13, 1968. No oil string run. D & A.

LOG

(Figures indicate bottom of formation — measurements from top of rotary bushing.)

175	Sand	
359	Clay, Shale & Shells	<u>C. F. S.</u>
500	Shale & Shells	4805
630	Red Beds	4815
655	Blaine	4841
1207	Shale & Shells	4932
1233	Anhydrite	4945
1820	Shale & Shells	4975
2000	Shale	
2300	Shale & Lime	
2871	Lime & Shale	
3250	Shale & Lime	<u>Slope Tests</u>
3600	Lime & Shale	2000
3895	Shale & Lime	2500
4055	Lime & Shale	3000
4190	Shale & Lime	3500
4255	Lime & Shale	4000
4720	Lime	4500
4805	Lime Chert	
4815	Mississippian	
4841	Lime & Chert	
4906	Lime	
4932	Lime & Sand	<u>S. L. M.</u>
4975	Sand RTD	
	Strap	4403.97
	Board	<u>4401.25</u>

No correction

RECEIVED
 STATE CORPORATION COMMISSION
 DEC 10 1968
 CONSERVATION DIVISION
 Wichita, Kansas

The undersigned, C. W. Sebitts, Attorney-in-Fact for PICKRELL DRILLING COMPANY, hereby certifies in behalf of said Company, that the above is a true and correct log of the formation encountered in drilling the above well as reflected by the Daily Drilling Reports.

PICKRELL DRILLING COMPANY

By [Signature]
 C. W. Sebitts Attorney-in-Fact

STATE OF KANSAS }

day of December, 1968, before me the undersigned, a Notary Public, in and for the County and State aforesaid, personally appeared C. W. Sebitts, to me known to be the individual person who subscribed the name of PICKRELL DRILLING COMPANY to the foregoing instrument as its Attorney-in-Fact and acknowledged to me that he executed the same as his free and voluntary act and deed, and as the free and voluntary act and deed of such company, for the uses and purposes therein set forth.

Given under my hand and seal of office the day and year last above written.

My commission expires: May 10, 1970

[Signature]
 L. M. Whiting Notary Public

