


STATE OF KANSAS
STATE CORPORATION COMMISSION

15-155-20454-0000

WELL PLUGGING RECORD

Give All Information Completely
Make Required Affidavit
Mail or Deliver Report to
Conservation Division
State Corporation Comm.
245 North Water
Wichita, KS 67202

Reno County, Sec. 11 Twp. 26 Rge. 6W E/W
Location as "NE/CNW/SW" or footage from lines
250' E of C W/2 N/2 NE/4
Lease Owner Harry A. Sprague
Lease Name Krebbiel "B" Well No. B#2
Office Address 625 W. Kansas, McPherson, Kansas 67460
Character of Well (Completed as Oil, Gas or Dry Hole)

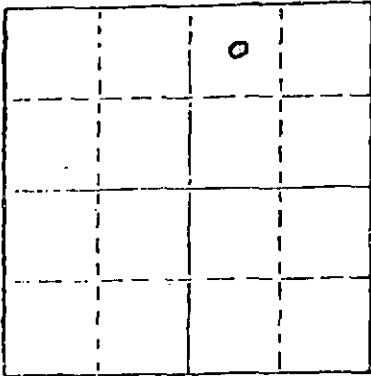

Locate well correctly on above
Section Plot

Dry Hole
Date Well completed 12/9 19 77
Application for plugging filed 19 77
Application for plugging approved 19
Plugging commenced 19
Plugging completed 12/9/ 19 77
Reason for abandonment of well or producing formation
Dry Hole

If a producing well is abandoned, date of last production 19

Was permission obtained from the Conservation Division or its agents before plugging was commenced? Yes

Name of Conservation Agent who supervised plugging of this well Hugh Scott
Producing formation Depth to top Bottom Total Depth of Well
Show depth and thickness of all water, oil and gas formations.

OIL, GAS OR WATER RECORDS

CASING RECORD

FORMATION	CONTENT	FROM	TO	SIZE	PUT IN	PULLED OUT
Sand		0	20'	8 5/8"	20'	None
Red Bed		20'	225'	8 5/8"	205'	None
Blue Shale		225'	282'	8 5/8"	57'	None

Describe in detail the manner in which the well was plugged, indicating where the mud fluid was placed and the method or methods used in introducing it into the hold. If cement or other plugs were used, state the character of same and depth placed, from feet to feet for each plug set.

Set 1st. plug with 25 sacks of cement at 300'. 2nd. plug set with 10 sacks of cement at 40'. 2 sacks of cement in rathole. Job completed at 2:00 P. M., December 9, 1977. Plugging completed by Hugh Scott, State Plugger, McPherson, Kansas.

RECEIVED
STATE CORPORATION COMMISSION

DEC 21 1977 12-21-77

(If additional description is necessary, use BACK of this form)
Name of Plugging Contractor Blackstone Drilling, Inc., P.O. Box 1184, McPherson, Ks. 67460

STATE OF Kansas COUNTY OF McPherson, ss.
Harry A. Sprague (employee of owner) or (owner or operator)
of the above-described well, being first duly sworn on oath, says: That I have knowledge of the facts, statements, and matters herein contained and the log of the above-described well as filed and that the same are true and correct. So help me God.


(Signature) Harry A. Sprague
625 W. Kansas, McPherson, Kansas 67460
(Address)

SUBSCRIBED AND SWORN TO before me this 20th day of December, 1977

Helen Harris
Notary Public.

My commission expires



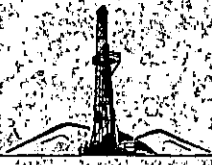

Blackstone Drilling, Inc.

Box 334, 523 West Kansas, Phone (316) 241-1250
McPHERSON, KANSAS 67460

December 9, 1977

15-155-20454-0000

COMPANY: HARRY A. SPRAGUE
 CONTRACTOR: BLACKSTONE DRILLING, INC.
 FARM: KREHBIEL B#2
 LOCATION: 250' E of C W/2 N/2 NE/4 Sec. 11-26-6W,
 Reno County, Kansas
 COMMENCED: December 1, 1977
 COMPLETED: December 9, 1977
 ELEVATION:

0	to	20	Sand
20	to	225	Red Bed
225	to	282	Blue Shale
282	to	921	Shale & Lime
921	to	1653	Lime & Shale
1653	to	2000	Shale
2000	to	2205	Lime
2205	to	2460	Lime & Shale
2460	to	3014	Shale & Lime
3014	to	3580	Lime
3580	to	3631	Shale
3631	to	3640	Mississippi
		3640	T. D.

Cut 12 1/2" hole to 282' and run 284' of 8 5/8" surface pipe, cemented with 175 sacks of cement at 282'. Plug down at 3:45 P. M., December 1, 1977. Hole dry and abandoned. Set 1st. plug with 25 sacks of cement at 300'. 2nd plug with 10 sacks of cement at 40', 2 sacks of cement in rat-hole. Plugging completed at 2:00 P. M., December 9, 1977. Plugging completed by Hugh Scott, State Plugger, McPherson, Kansas

TOPS: MISSISSIPPI - 3631'

Measurements taken from K. B.

RECEIVED
STATE CORPORATION COMMISSION

DEC 21 1977

CERTIFICATE

CONSERVATION DIVISION
Wichita, Kansas

I, P. E. Plouffe, President of Blackstone Drilling, Inc. do hereby certify that the above and foregoing is a true and correct copy of log on your Krehbiel B#2, located 250' E. of C W/2 N/2 NE/4, Section 11-26-6W, Reno County, Kansas as reflected by the files of Blackstone Drilling, Inc.

P. E. Plouffe, President

Subscribed and sworn to before me a Notary Public in and for McPherson County, Kansas this 17th day of December, 1977.

Johnnie L. Schmidt - Notary Public

JOHNNIE L. SCHMIDT
 McPherson County, Kansas
 My Appr. Exp. June 23, 1981