


STATE OF KANSAS
STATE CORPORATION COMMISSION

WELL PLUGGING RECORD

*Give All Information Completely
Make Required Affidavit
Mail or Deliver Report to:
Conservation Division
State Corporation Commission
211 No. Broadway
Wichita, Kansas

Reno County, Sec. 11 Twp. 26S Rge. 6 (E) W (W)
Location as "NE/CNW/SW" or footage from lines NW SW
Lease Owner Petroleum Operating Company
Lease Name Collingwood Well No. 1
Office Address P. O. Box 7027 Tulsa, Oklahoma
Character of Well (completed as Oil, Gas or Dry Hole) dry hole
Date well completed June 23 19 58
Application for plugging filed June 23 19 58
Application for plugging approved June 23 19 58
Plugging commenced June 23 19 58
Plugging completed 9:00 P. M. June 23 19 58
Reason for abandonment of well or producing formation dry hole

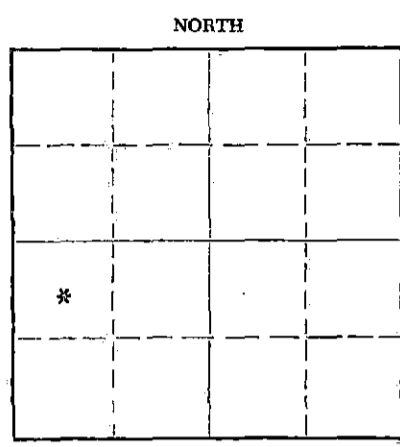

Locate well correctly on above Section Plat

If a producing well is abandoned, date of last production _____ 19____
Was permission obtained from the Conservation Division or its agents before plugging was commenced? Yes

Name of Conservation Agent who supervised plugging of this well Fred W. Hampe
Producing formation _____ Depth to top _____ Bottom _____ Total Depth of Well 4192 Feet
Show depth and thickness of all water, oil and gas formations.

OIL, GAS OR WATER RECORDS

CASING RECORD

FORMATION	CONTENT	FROM	TO	SIZE	PUT IN	PULLED OUT
Surface Pipe		-0-	213'	8 5/8"	213'	-0-

Describe in detail the manner in which the well was plugged, indicating where the mud fluid was placed and the method or methods used in introducing it into the hole. If cement or other plugs were used, state the character of same and depth placed, from _____ feet to _____ feet for each plug set.

Ran drill pipe to bottom and gunned pits and circulated with heavy mud.
Filled hole with heavy mud to 200'.
Set plug with 1/3 sack hulls.
Dumped 20 sacks regular cement.
Filled with heavy mud to 35'.
Set plug at 35' with 1/3 sack hulls and 10 sacks cement.
Cement to bottom of cellar.

7-10-58

Wichita, Kansas

(If additional description is necessary, use BACK of this sheet)

Name of Plugging Contractor A. L. Jackson Drilling Company
Address Box 194 Great Bend, Kansas

STATE OF Kansas, COUNTY OF Barton, ss.
A. L. Jackson, contractor on _____ of the above-described well, being first duly sworn on oath, says: That I have knowledge of the facts, statements, and matters herein contained and the log of the above-described well as filed and that the same are true and correct. So help me God.

(Signature) A. L. Jackson
Box 194 Great Bend, Kansas
(Address)

SUBSCRIBED AND SWORN TO before me this 26th day of June, 1958

Dick B. Evans
Dick B. Evans Notary Public.

My commission expires May 9, 1959.

PLUGGING
FILE SEC 11 T 26 R 6W
BOOK PAGE 110 LINE 44

15-155-06075-0000

W E L L L O G
Collingwood # 1
NW SW 11-26S-6W
Reno County, Kansas

0 - 60	Sand and surface clay	<u>Elevation</u>	1538 D. F.
60 - 75	Shale and lime		
75 - 105	Shale, shells and sand	<u>Formation Tops:</u>	
105 - 213	Shale and shells	Lansing	2945'
213 - 380	Shale and shells	Mississippi	3641'
380 - 610	Salt		
610 - 765	Shale and shells	Viola	4027'
765 - 1060	Shale and lime	Simpson	4052'
1060 - 1147	Lime	Arbuckle	4157'
1147 - 1440	Lime and shale		
1440 - 1575	Lime - broken		
1575 - 1645	Shale with lime streaks		
1645 - 2520	Shale and lime		
2520 - 2620	Lime with shale breaks		
2620 - 2815	Shale		
2815 - 2945	Shale and lime		
2945 - 3436	Lime		
3436 - 3641	Lime and shale		
3641 - 3656	Mississippi		
3656 - 3667	Chert		
3667 - 3750	Mississippi Lime - cherty		
3750 - 3766	Mississippi lime		
3766 - 3790	Lime and shale		
3790 - 3812	Mississippi and shale		
3812 - 3822	Lime		
3822 - 3841	Shale		
3841 - 3990	Shale with lime streaks		
3990 - 4029	Shale and lime		
4029 - 4030	Viola lime		
4030 - 4051	Lime and chert		
4051 - 4054	Shale		
4054 - 4074	Shale and lime		
4074 - 4095	Simpson sand and shale		
4095 - 4115	Sand and shale		
4115 - 4145	Shale and lime		
4145 - 4192	Lime		
4192	T. D.		

STATE CORPORATION COMMISSION

JUL 10 1958

CONSERVATION DIVISION
Wichita, Kansas

STATE OF KANSAS

COUNTY OF BARTON

A. L. Jackson, owner of A. L. Jackson Drilling Company, being first duly sworn on oath says: That I have knowledge of the facts, statements and matters herein contained and the log of the above described well as filed and that the same are true and correct.

A. L. Jackson
A. L. Jackson

Subscribed and sworn before me this 26th day of June, 1958.

Dick E. Evans
Dick E. Evans
Notary Public Barton County

My Commission Expires: May 9, 1959.

PLUGGING
FILE SEC 11. T. 26 R. 6W
BOOK PAGE 110 LINE 44