

This form shall be filed in duplicate with the Kansas Corporation Commission, 200 Colorado Derby Building, Wichita, Kansas 67202, within ten days after the completion of the well, regardless of how the well was completed.

Attach separate letter of request if the information is to be held confidential. If confidential, only file one copy. Information on side one will be of public record and side two will then be held confidential.

Circle one: Oil, Gas, (Dry) SWD, OWWO, Injection. Type and complete ALL sections. Applications must be filed for dual completion, commingling, SWD and injection, T.A.

Attach wireline logs (i.e. electrical log, sonic log, gamma ray neutron log, etc.). KCC # (316) 263-3238. (Rules 82-2-105 & 82-2-125)

OPERATOR W. L. KIRKMAN, INC.

API NO. 185-21,555-0000

ADDRESS P. O. Box 18611

COUNTY Stafford

Wichita, KS 67207

FIELD -----

**CONTACT PERSON WAYNE L. KIRKMAN

PROD. FORMATION NONE

PHONE (316) 685-5372

LEASE McFadden "A"

PURCHASER None - Dry Hole

WELL NO. X2

ADDRESS -----

WELL LOCATION SW NE SE

DRILLING ALDEBARAN DRILLING CO. INC.

1650 Ft. from S Line and

CONTRACTOR


990 Ft. from E Line of

ADDRESS P. O. Box 18611

the SE/4 SEC. 10 TWP. 25S RGE. 12W

Wichita, KS 67207

WELL PLAT

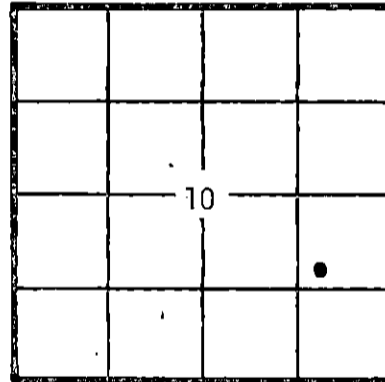

KCC [check] KGS [check] (Office Use)

PLUGGING SUN OIL WELL CEMENTING, INC.

CONTRACTOR

ADDRESS Box 169

Great Bend, KS 67530

TOTAL DEPTH 4230 PBTD -----

SPUD DATE 2/11/82 DATE COMPLETED 2/23/82

ELEV: GR 1858 DF 1865 KB 1867

DRILLED WITH (CABLE) (ROTARY) (AIR) TOOLS

Amount of surface pipe set and cemented 396 DV Tool Used

AFFIDAVIT

STATE OF KANSAS, COUNTY OF SEDGWICK

L. KIRKMAN OF LAWFUL AGE, BEING FIRST DULY SWORN UPON HIS OATH

DEPOSES THAT HE IS PRESIDENT (FOR)(OF) W. L. KIRKMAN, INC.

OPERATOR OF THE McFadden "A" LEASE, AND IS DULY AUTHORIZED TO MAKE

THIS AFFIDAVIT FOR AND ON THE BEHALF OF SAID OPERATOR, THAT WELL NO. 1 ON

SAID LEASE HAS BEEN COMPLETED AS OF THE 23 DAY OF February, 19 82, AND THAT

ALL INFORMATION ENTERED HEREIN WITH RESPECT TO SAID WELL IS TRUE AND CORRECT.

FURTHER AFFIANT SAITH NOT.

SUBSCRIBED AND SWORN BEFORE ME THIS 18th DAY OF March, 19 82.

(S) Wayne L. Kirkman

Kathleen G. Quinn

NOTARY PUBLIC Kathleen G. Quinn

KATHLEEN G. QUINN STATE NOTARY PUBLIC Sedgwick County, Kansas MY COMMISSION EXPIRES: March 20, 1983

**The person who can be reached by phone regarding any questions concerning this information. Within 45 days of completion, a witnessed initial test by the Commission is required if the well produces more than 25 BOPD or is located in a Basic Order Pool.

SIDE TWO

WELL LOG

Show all important zones of porosity and contents thereof; cored intervals, and all drill-stem tests, including depth interval tested, cushion used, time tool open, flowing and shut-in pressures, and recoveries.

SHOW GEOLOGICAL MARKERS, LOGS RUN, OR OTHER DESCRIPTIVE INFORMATION.

FORMATION DESCRIPTION, CONTENTS, ETC.	TOP	BOTTOM	NAME	DEPTH
NOTE: SEE ATTACHED DAILY WELL REPORT				

Report of all strings set — surface, intermediate, production, etc. **CASING RECORD** (New) or (Used)

Purpose of string	Size hole drilled	Size casing set (in O.D.)	Weight lbs/ft.	Setting depth	Type cement	Socks	Type and percent additives
SURFACE	12 1/4	8 5/8	24#	393'	Common	350	2% Ge1, 3% CC

NA - DRY HOLE

LINER RECORD

PERFORATION RECORD

Top, ft.	Bottom, ft.	Sacks cement	Shots per ft.	Size & type	Depth interval

TUBING RECORD		
Size	Setting depth	Packer set at

NA - DRY HOLE

ACID, FRACTURE, SHOT, CEMENT SQUEEZE RECORD

Amount and kind of material used	Depth interval treated

Date of first production	Producing method (flowing, pumping, gas lift, etc.)	Gravity
NONE - DRY HOLE		
RATE OF PRODUCTION PER 24 HOURS	Oil bbls.	Gas MCF
Disposition of gas (vented, used on lease or sold)	Water %	Gas-oil ratio CFPB
	Perforations	

SIDE ONE

AFFIDAVIT OF COMPLETION FORM

This form shall be filed in duplicate with the Kansas Corporation Commission, 200 Colorado Derby Building, Wichita, Kansas 67202, within ten days after the completion of the well, regardless of how the well was completed.

Attach separate letter of request if the information is to be held confidential. If confidential, only file one copy. Information on side one will be of public record and side two will then be held confidential.

Circle one: Oil, Gas, Dry SWD, OWWO, Injection. Type and complete ALL sections. Applications must be filed for dual completion, commingling, SWD and injection, T:A.

Attach wireline logs (i.e. electrical log, sonic log, gamma ray neutron log, etc.). KCC # (316) 263-3238. (Rules 82-2-105 & 82-2-125)

OPERATOR W. L. KIRKMAN, INC.

API NO. 185-21,555

ADDRESS P. O. Box 18611 Wichita, KS 67207

COUNTY Stafford FIELD GRAREY

**CONTACT PERSON WAYNE L. KIRKMAN PHONE (316) 685-5372

PROD. FORMATION NONE

PURCHASER None - Dry Hole

LEASE McFadden "A"

ADDRESS

WELL NO. X: 2

DRILLING ALDEBARAN DRILLING CO. INC.

WELL LOCATION SW NE SE

CONTRACTOR

1650 Ft. from S Line and

ADDRESS P. O. Box 18611

990 Ft. from E Line of

Wichita, KS 67207

the SE/4 SEC. 10 TWP. 25S RGE. 12W

PLUGGING SUN OIL WELL CEMENTING, INC.

CONTRACTOR

ADDRESS Box 169

Great Bend, KS 67530


TOTAL DEPTH 4230 PBTD

SPUD DATE 2/11/82 DATE COMPLETED 2/23/82

ELEV: GR 1858 DF 1865 KB 1867

DRILLED WITH (CABLE) (ROTARY) (AIR) TOOLS

Amount of surface pipe set and cemented 396 DV Tool Used? Yes

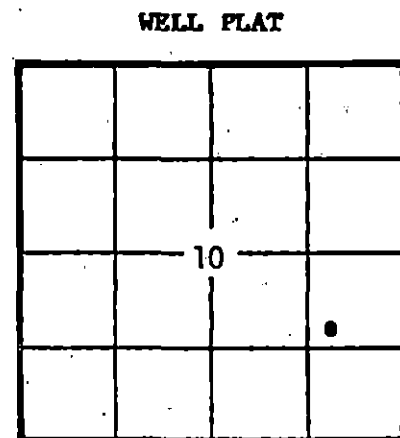

KCC KGS (Office Use)

AFFIDAVIT

STATE OF KANSAS, COUNTY OF SEDGWICK SS, I, WAYNE

L. KIRKMAN OF LAWFUL AGE, BEING FIRST DULY SWORN UPON HIS OATH,

DEPOSES THAT HE IS PRESIDENT (FOR)(OF) W. L. KIRKMAN, INC.

OPERATOR OF THE McFadden "A" LEASE, AND IS DULY AUTHORIZED TO MAKE

THIS AFFIDAVIT FOR AND ON THE BEHALF OF SAID OPERATOR, THAT WELL NO. 1 ON

SAID LEASE HAS BEEN COMPLETED AS OF THE 23 DAY OF February, 19 82, AND THAT

ALL INFORMATION ENTERED HEREIN WITH RESPECT TO SAID WELL IS TRUE AND CORRECT.

FURTHER AFFIRMATION WITH NOT.

SUBSCRIBED AND SWORN BEFORE ME THIS 18th DAY OF March, 19 82.

RECEIVED STATE CORPORATION COMMISSION MAR 23 1982 CONSERVATION DIVISION WICHITA KANSAS

(S) Wayne L. Kirkman

Kathleen G. Quinn NOTARY PUBLIC Kathleen G. Quinn

KATHLEEN G. QUINN STATE NOTARY PUBLIC Sedgewick County, Kansas MY COMMISSION EXPIRES: March 20, 1983

**The person who can be reached by phone regarding any questions concerning this information. Within 45 days of completion, a witnessed initial test by the Commission is required if the well produces more than 25 BOPD or is located in a Basic Order Pool.

SIDE TWO

WELL LOG

Show all important zones of porosity and contents thereof; cored intervals, and all drill-stem tests, including depth interval tested, cushion used, time tool open, flowing and shut-in pressures, and recoveries.

SHOW GEOLOGICAL MARKERS, LOGS RUN, OR OTHER DESCRIPTIVE INFORMATION.

FORMATION DESCRIPTION, CONTENTS, ETC.	TOP	BOTTOM	NAME	DEPTH
NOTE: SEE ATTACHED DAILY WELL REPORT				

Report of all strings set— surface, intermediate, production, etc. **CASING RECORD (New) or (Used)**

Purpose of string	Size hole drilled	Size casing set (in O.D.)	Weight lbs/ft.	Setting depth	Type cement	Socks	Type and percent additives
SURFACE	12 1/4	8 5/8	24#	393'	Common	350	2% Gel, 3% CC

NA - DRY HOLE

LINER RECORD

PERFORATION RECORD

Top, ft.	Bottom, ft.	Socks cement	Shots per ft.	Size & type	Depth interval

TUBING RECORD		
Size	Setting depth	Packer set at

NA - DRY HOLE

ACID, FRACTURE, SHOT, CEMENT SQUEEZE RECORD

Amount and kind of material used	Depth interval treated

Date of first production NONE - DRY HOLE	Producing method (flowing, pumping, gas lift, etc.)	Gravity
RATE OF PRODUCTION PER 24 HOURS	Oil bbls.	Gas MCF
Disposition of gas (vented, used on lease or sold)	Water %	Gas-oil ratio CFPS
Perforations		