


Give All Information Completely
Make Required Affidavit.
Mail or Deliver Report to:
Conservation Division
State Corporation Commission
211 No. Broadway
Wichita, Kansas

WELL PLUGGING RECORD

NORTH

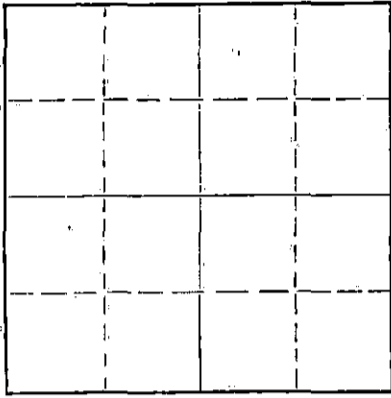

Locate well correctly on above
Section Plat

Kiowa County, Sec. 10 Twp. 27 Rge. 16 (E) W (W)
Location as "NE/CNW%SW%" or footage from lines NW SE SE
Lease Owner Bowers Drilling Company, Inc.
Lease Name Pyle Well No. 1
Office Address Wichita, Kansas
Character of Well (completed as Oil, Gas or Dry Hole)
Date well completed 19
Application for plugging filed 19
Application for plugging approved 19
Plugging commenced 2-1-63 19
Plugging completed 2-8-63 19
Reason for abandonment of well or producing formation Depleted.

If a producing well is abandoned, date of last production 19
Was permission obtained from the Conservation Division or its agents before plugging was commenced? yes

Name of Conservation Agent who supervised plugging of this well Archie Elving
Producing formation Depth to top Bottom Total Depth of Well 4695 Feet
Show depth and thickness of all water, oil and gas formations.

OIL, GAS OR WATER RECORDS

CASING RECORD

FORMATION	CONTENT	FROM	TO	SIZE	PUT IN	PULLED OUT
				8-5/8"	370'	None
				4-1/2"	4677'	4040'

Describe in detail the manner in which the well was plugged, indicating where the mud fluid was placed and the method or methods used in introducing it into the hole. If cement or other plugs were used, state the character of same and depth placed, from feet to feet for each plug set.

Checked hole to 4542', sanded to 4530' and dumped 3 sacks of cement @ 4530' with dump bailer. Pulled 4 1/2" casing. Bailed fluid to 200', set rock bridge to 190' and ran 20 sacks of cement @ 190'. Mudded to 40', set rock bridge to 30' and ran 10 sacks of cement to base of cellar.

RECEIVED BY
STATE CORPORATION COMMISSION

PLUGGING COMPLETE.

2-19-63 FEB 19 1963

CONSERVATION DIVISION
Wichita, Kansas

(If additional description is necessary, use BACK of this sheet)
Name of Plugging Contractor KNIGHT CASING PULLING COMPANY
Address CHASE, KANSAS

STATE OF KANSAS, COUNTY OF RICE, ss.
Noel J. Knight (employee of owner) or (owner) of the above-described well, being first duly sworn on oath, says: That I have knowledge of the facts, statements, and matters herein contained and the log of the above-described well as filed and that the same are true and correct. So help me God.

(Signature) Noel J. Knight
Chase, Kansas
(Address)

SUBSCRIBED AND SWORN TO before me this 13th day of February, 1963

Milton J. Volin
Notary Public.

My commission expires May 20, 1964



WELL LOG

COMPANY: Bowers Drilling Company, Inc.
CONTRACTOR: Bowers Drilling Company, Inc.
FARM: Pyle #1
LOCATION: NW SE SE Section 10-27-16, Kiowa County, Kansas
COMMENCED: 11-13-62
COMPLETED: 11-30-62
ELEVATION: 2088 K.B.

0 - 40 Sand and clay
40 - 280 Sand and shale
280 - 369 Shale and clay
369 - 1014 Shale and redbed
1014 - 1035 Anhydrite
1035 - 1270 Shale
1270 - 1710 Shale and shell
1710 - 2115 Shale
2115 - 2590 Lime and Shale
2590 - 2730 Shale and lime streaks
2730 - 4510 Lime and Shale
4510 - 4550 Lime
4550 - 4615 Lime and chert
4615 - 4635 Sand
4635 - 4655 Sand and lime
4655 - 4695 Lime and shale
4695 T. D.

RECEIVED
CONSERVATION COMMISSION

MAR 20 1963

CONSERVATION COMMISSION
Wichita, Kansas

8-5/8" set at 369' with 250 sax

4 1/2" casing set at 4677 with 100 sax

LOG TOPS:

Maebauer Shale 3882 Marmaton Group 4394 Miss. Chert 4556
Brown Lime 4038 Cherokee Group 4507 Kindereek 4602
Lansing Limes 4056 Cherokee Sand 4529 Viola 4672
Base K.C. 4377

STATE OF KANSAS)
) 38
COUNTY OF SEDGWICK)

I, Emil E. Bowers, do hereby certify that the above and foregoing is a true and correct copy of the copy of the log of the Pyle #1, NW SE SE Section 10-27-16, Kiowa County, Kansas, as reflected by the files of Bowers Drilling Company, Inc.

Emil E. Bowers
Emil E. Bowers

Subscribed and sworn to before me, a Notary Public, in and for Sedgwick County, Kansas, this 10th day of December, 1962.

Donna F. Miller
Donna F. Miller, Notary Public

My commission expires May 1, 1966.