


STATE OF KANSAS
STATE CORPORATION COMMISSION

WELL PLUGGING RECORD

Give All Information Completely
Make Required Affidavit
Mail or Deliver Report to
Conservation Division
State Corporation Comm.
245 North Water
Wichita, KS 67202

Kiowa County, Sec. 4 Twp. 27 Rge. 16 E/W
Location as "NE/CNW $\frac{1}{4}$ SW $\frac{1}{4}$ " or footage from lines
C SE NW
Lease Owner ~~XXXXXX~~ J. Mark Richardson
Lease Name Baker #2 Well No.
Office Address Wichita, Kansas 67202
Character of Well (Completed as Oil, Gas or Dry Hole)

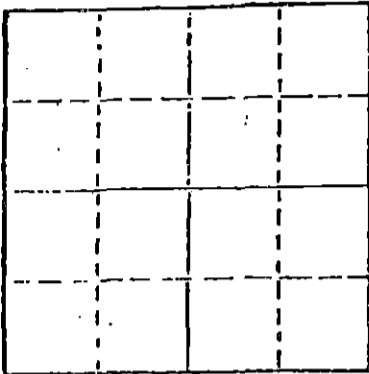

Locate well correctly on above
Section Plat

Date Well completed 19
Application for plugging filed 19
Application for plugging approved 19
Plugging commenced 6/11/80 19
Plugging completed 6/16/80 19
Reason for abandonment of well or producing formation
depleted
If a producing well is abandoned, date of last production 19

Was permission obtained from the Conservation Division or
its agents before plugging was commenced? yes

Name of Conservation Agent who supervised plugging of this well Owen
Producing formation Depth to top Bottom Total Depth of Well 4550
Show depth and thickness of all water, oil and gas formations.

OIL, GAS OR WATER RECORDS

CASING RECORD

FORMATION	CONTENT	FROM	TO	SIZE	PUT IN	PULLED OUT
				8-5/8	482	none
				4 1/2"	4549	2818'

Describe in detail the manner in which the well was plugged, indicating where the mud fluid
was placed and the method or methods used in introducing it into the hold. If cement or other
plugs were used, state the character of same and depth placed, from feet to
feet for each plug set.

Sanded to 4450' and ran 4 sack s cement. Shot pipe at 3700', 3510', 3320', 3125', 3000',
2800', pulled 88 joints. Squeezed hole with 15 sacks gel, 8 sacks hulls, 10 sacks gel.
Released plug and displaced with 125 sacks 50-50 pozmix, 4% gel and 3% cc.

PLUGGING COMPLETE.

RECEIVED
STATE CORPORATION COMMISSION

JUN 26 1980

(If additional description is necessary, use BACK of this sheet)

Name of Plugging Contractor KELSO CASING PULLING

CHASE, KANSAS

STATE OF KANSAS COUNTY OF RICE, ss.
R. DARRELL KELSO (employee of owner) or (owner or operator)
of the above-described well, being first duly sworn on oath, says: That I have knowledge of
the facts, statements, and matters herein contained and the log of the above-described well
as filed and that the same are true and correct. So help me God.

(Signature)

R. Darrell Kelso
CHASE, KANSAS

(Address)
June

SUBSCRIBED AND SWORN TO before me this 25th day of June, 19 80

My commission expires



Margaret Melcher
Notary Public.