


STATE OF KANSAS
STATE CORPORATION COMMISSION

WELL PLUGGING RECORD

Give All Information Completely
Make Required Affidavit
Mail or Deliver Report to:
Conservation Division
State Corporation Commission
221 No. Broadway
Wichita, Kansas

Kiowa County, Sec. 4 Twp. 27 Rge. (E) 16 (W)

NORTH

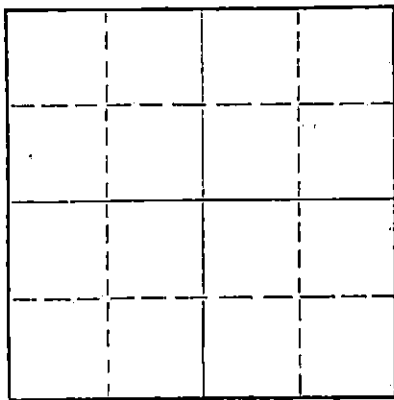

Locate well correctly on above
Section Plat

Location as "NE/CNW/SW" or footage from lines CNE SW
Lease Owner Quality Supply Co.
Lease Name Lillie French Well No. 1
Office Address 701 Union Nat'l Bldg, Wichita, Kansas
Character of Well (completed as Oil, Gas or Dry Hole) Oil
Date well completed _____ 19____
Application for plugging filed _____ 19____
Application for plugging approved _____ 19____
Plugging commenced 6-11 1962
Plugging completed 6-16 1962
Reason for abandonment of well or producing formation _____

If a producing well is abandoned, date of last production _____ 19____
Was permission obtained from the Conservation Division or its agents before plugging was commenced? yes

Name of Conservation Agent who supervised plugging of this well W. L. LaCkamp Jr.
Producing formation _____ Depth to top _____ Bottom _____ Total Depth of Well 4700' Feet
Show depth and thickness of all water, oil and gas formations.

OIL, GAS OR WATER RECORDS

CASING RECORD

FORMATION	CONTENT	FROM	TD	SIZE	PUT IN	PULLED OUT
				8 5/8"	415	none
				5 1/2"	4681'	3487'

Describe in detail the manner in which the well was plugged, indicating where the mud fluid was placed and the method or methods used in introducing it into the hole. If cement or other plugs were used, state the character of same and depth placed, from _____ feet to _____ feet for each plug set.

Top perforation 4525'

Sanded hole to 4510'-dumped 5 sks cement-
pulled casing-mudded hole-bailed fluid down
to 350'-set 10' rock bridge-dumped 25 sks
cement-mudded hole to 35'-set 10' rock bridge
dumped 10 sks cement.

RECEIVED
STATE CORPORATION COMMISSION

6-27-62 JUN 27 1962

CONSERVATION DIVISION
Wichita, Kansas

(If additional description is necessary, use BACK of this sheet)

Name of Plugging Contractor R & D Casing Pulling Co. License #236
Address Box 572, Hutchinson, Kansas

STATE OF Kansas COUNTY OF Sedgewick, ss.
Jack Shear of H. Quality Supply Company (employed or owner) or (owner or operator) of the above-described well, being first duly sworn on oath, says: That I have knowledge of the facts, statements, and matters herein contained and the log of the above-described well as filed and that the same are true and correct. So help me God.

(Signature)

SUBSCRIBED AND SWORN TO before me this 25 day of June, 1962
701 Union Nat'l Bldg.
Wichita, KS.

My commission expires Dec. 22, 1962
Evelyn V. North
Notary Public.

WELL LOG

COMPANY: Sunray Mid-Continent Oil Company

Sec. 4-27S-16W

FARM: Lily French No. 1

Loc. NE SW

TOTAL DEPTH: 4700'

County - Kiowa

COMM: 12-22-57. COMP: 1-8-58.

CASING

ELEVATION

8-5/8" = 428'
5-1/2" = 4694'

D.F. --- *na*
Gr. ---

DRILLER'S LOG

Surface Soil & Sand	0	150
Shale & Red Bed	150	1345
Shale & Lime	1345	2397
Lime	2397	2815
Lime & Shale	2815	4058
Lime	4058	4482
Lime & Chert	4482	4502
Chert	4502	4539
Core No. 1	4539	4579
Lime & Chert	4579	4596
Lime	4596	4700
Total Depth		4700

RECEIVED
STATE CORPORATION COMMISSION

JUN 27 1962
CONSERVATION DIVISION
Wichita, Kansas