


STATE OF KANSAS  
STATE CORPORATION COMMISSION

WELL PLUGGING RECORD

Give All Information Completely  
Make Required Affidavit  
Mail or Deliver Report to  
Conservation Division  
State Corporation Comm.  
245 North Water  
Wichita, KS 67202

Kiowa County, Sec. 3 Twp. 27 Rge. 16 E/W  
Location as "NE/CNW $\frac{1}{4}$ SW $\frac{1}{4}$ " or footage from lines  
C of NE SE

Lease Owner Imperial Oil Company  
Lease Name Long #1-3 Well No. \_\_\_\_\_  
Office Address Great Bend, Kansas 67530  
Character of Well (Completed as Oil, Gas or Dry Hole) \_\_\_\_\_

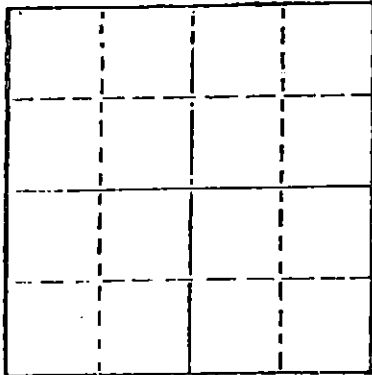

Locate well correctly on above  
Section Plat

Date Well completed \_\_\_\_\_ 19\_\_\_\_  
Application for plugging filed \_\_\_\_\_ 19\_\_\_\_  
Application for plugging approved \_\_\_\_\_ 19\_\_\_\_  
Plugging commenced 11/16/77 \_\_\_\_\_ 19\_\_\_\_  
Plugging completed 11/19/77 \_\_\_\_\_ 19\_\_\_\_  
Reason for abandonment of well or producing formation  
depleted. \_\_\_\_\_

If a producing well is abandoned, date of last production  
\_\_\_\_\_ 19\_\_\_\_

Was permission obtained from the Conservation Division or  
its agents before plugging was commenced? yes \_\_\_\_\_

Name of Conservation Agent who supervised plugging of this well Owens  
Producing formation \_\_\_\_\_ Depth to top \_\_\_\_\_ Bottom \_\_\_\_\_ Total Depth of Well 4530  
Show depth and thickness of all water, oil and gas formations.

RECEIVED  
STATE CORPORATION COMMISSION  
NOV 28 1977  
CONSERVATION DIVISION  
Wichita, Kansas

FORMATION RECORDS				CASING RECORD		
FORMATION	CONTENT	FROM	TO	SIZE	PUT IN	PULLED OUT
				8-5/8	366	none
				4-1/2	4517	3427'

Describe in detail the manner in which the well was plugged, indicating where the mud fluid was placed and the method or methods used in introducing it into the hold. If cement or other plugs were used, state the character of same and depth placed, from \_\_\_\_\_ feet to \_\_\_\_\_ feet for each plug set.

Sanded to 4475' and ran 4 sacks cement. Shot pipe at 3535', 3410', pulled 109 joints. Squeezed hole with 3 sacks hulls, 25 sacks gel, released plug and displaced with 125 sacks 50/50 pozmix w/2% cc.

PLUGGING COMPLETE.

(If additional description is necessary, use BACK of this sheet)

Name of Plugging Contractor KELSO CASING PULLING  
CHASE, KANSAS

STATE OF KANSAS COUNTY OF RICE, ss.  
R. DARRELL KELSO (employee of owner) or (owner or operator)  
of the above-described well, being first duly sworn on oath, says: That I have knowledge of the facts, statements, and matters herein contained and the log of the above-described well as filed and that the same are true and correct. So help me God.

(Signature) [Signature]  
CHASE, KANSAS  
(Address)

SUBSCRIBED AND SWORN TO before me this 23rd day of November, 19 77



My commission expires \_\_\_\_\_

[Signature]  
Notary Public.