


STATE OF KANSAS
STATE CORPORATION COMMISSION

WELL PLUGGING RECORD

Give All Information Completely
Make Required Affidavit
Mail or Deliver Report to:
Conservation Division
State Corporation Commission
212 North Market, Insurance Bldg.
Wichita, Kansas

Kingman County, Sec 14 Twp. 27 Rge. 10 (E) W(W)
Location as "NE/CNW/SW" or footage from lines NE SW NW
Lease Owner Lawrence Supply Co., Inc.
Lease Name McMichael #4 Well No.
Office Address Great Bend, Kansas
Character of Well (completed as Oil, Gas or Dry Hole)
Date well completed 19
Application for plugging filed 19
Application for plugging approved 19
Plugging commenced 1-6-59 19
Plugging completed 1-24-59 19
Reason for abandonment of well or producing formation

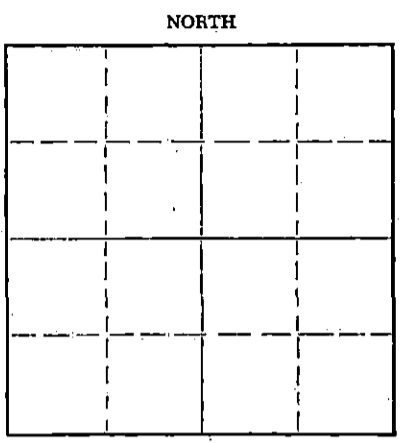

Locate well correctly on above
Section Plat

If a producing well is abandoned, date of last production 19
Was permission obtained from the Conservation Division or its agents before plugging was commenced? Yes

Name of Conservation Agent who supervised plugging of this well Fred Hample
Producing formation Depth to top Bottom Total Depth of Well 4281 1/2 Feet
Show depth and thickness of all water, oil and gas formations.

OIL, GAS OR WATER RECORDS

CASING RECORD

FORMATION	CONTENT	FROM	TO	SIZE	PUT IN	PULLED OUT
				8-5/8"	203'	none
				5-1/2"	4281'	2818'

Describe in detail the manner in which the well was plugged, indicating where the mud fluid was placed and the method or methods used in introducing it into the hole. If cement or other plugs were used, state the character of same and depth placed, from feet to feet for each plug set.

Checked the hole to 4060' and found it open. Filled w/sand to 4000' and dumped 5 sacks of cement with bailer. Pulled 30 jts of 5 1/2" casing and circulated pipe with 32 sacks of gel mud. Pulled rest of casing, cleared hole and checked fluid to 50', bailed to 200', set rock bridge to 190' and ran 20 sacks of cement. Mudded the hole to 40', set rock bridge to 30' and ran 10 sacks of cement to base of cellar.

PLUGGING COMPLETED

RECEIVED
STATE CORPORATION COMMISSION

JAN 29 1959 1-29-59

CONSERVATION DIVISION
Wichita, Kansas

Name of Plugging Contractor West Supply Co., Inc.
Address Chase, Kansas

STATE OF KANSAS, COUNTY OF RICE, ss.
I, Noel J. Knight (employee of owner) or (owner) of the above-described well, being first duly sworn on oath, says: That I have knowledge of the facts, statements, and matters herein contained and the log of the above-described well as filed and that the same are true and correct. So help me God.

(Signature) Noel J. Knight
Chase, Kansas (Address)

SUBSCRIBED AND SWORN to before me this 28th day of January, 1959

My commission expires 9-27-62 Notary Public.

PLUGGING
FILE SEC. 14 T. 27 R. 10
BOOK PAGE 6 LINE 40

Bennett & Roberts Drilling Co.
McMichael #4

NE SW NW 14-127-10W
Kingman County, Ks.

R.T.D. 4281 1/2

Commenced 1/24/56
Completed 2/3/56

Tops	
Cimarron Anhydrite	685
Mississippi Chert	4010
Kinderhook Shale	4078
Kinderhook Dolomite	4212
Kinderhook Sand (Miser)	4277
Viola Chert	4280

Casing Record

8 5/8" Set @ 203' w/250 sx cmt.
tr/5 1/2" Set @ 4281' w/100 sx cmt.

----- Figures Indicate Bottom of Formation -----

Surface Soil & Sand	203
Red Bed	400
Anhydrite	410
Shale & Red Bed	685
Anhydrite	725
Shale & Shells	1415
Shale & Lime	3060
Lime	3140
Lime & Shale	3583
Lime	3903
Lime & Shale	4004
Lime	4010
Chert & Lime	4053
Lime	4068
Shale & Lime	4281 1/2

PB-4060-
Prof. 4013-24

RECEIVED
STATE COMMISSIONER OF GEOL. & NAT. RES.
DEC 31 1958
CONSERVATION DIVISION
Wichita, Kansas

STATE OF KANSAS)
RUSSELL COUNTY) SS.

I hereby certify that the above information is correct to the best of my knowledge.

BENNETT & ROBERTS DRILLING CO.

By Bus Lake

Subscribed and sworn to before me this 14th day of February, 1956.

Charles L. Hummel
Notary Public

My Commission Expires 6/17/58

PLUGGING
FILE - SEC 14 T. 27 R. 10W
BOOK PAGE 6 LINE 70