

STATE OF KANSAS
STATE CORPORATION COMMISSION


WELL PLUGGING RECORD

Give All Information Completely
Make Required Affidavit
Mail or Deliver Report to:
Conservation Division
State Corporation Commission
212 North Market, Insurance Bldg.
Wichita, Kansas

Kingman County, Sec. 14 Twp. 27 Rge. 10 (E)W (W)

Location as "NE/CNW/SW" or footage from lines CW/2 SW SW
Lease Owner Lawrence Supply Co., Inc.
Lease Name Sale #1 Well No. _____
Office Address Great Bend, Kansas
Character of Well (completed as Oil, Gas or Dry Hole) _____
Date well completed _____ 19____
Application for plugging filed _____ 19____
Application for plugging approved _____ 19____
Plugging commenced 2-4-59 _____ 19____
Plugging completed 2-7-59 _____ 19____
Reason for abandonment of well or producing formation _____

NORTH

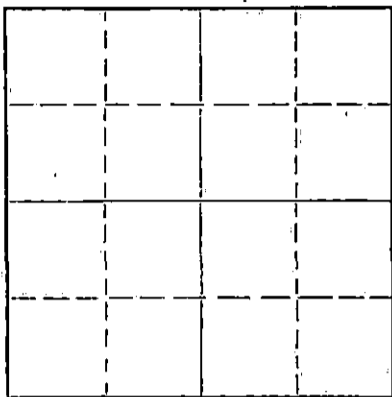

Locate well correctly on above
Section Plat

If a producing well is abandoned, date of last production _____ 19____
Was permission obtained from the Conservation Division or its agents before plugging was commenced? yes

Name of Conservation Agent who supervised plugging of this well Fred Hampel
Producing formation _____ Depth to top _____ Bottom _____ Total Depth of Well 4311 Feet
Show depth and thickness of all water, oil and gas formations.

OIL, GAS OR WATER RECORDS

CASING RECORD

FORMATION	CONTENT	FROM	TO	SIZE	PUT IN	PULLED OUT
				8-5/8"	208'	none
				5-1/2"	4309'	3620'

Describe in detail the manner in which the well was plugged, indicating where the mud fluid was placed and the method or methods used in introducing it into the hole. If cement or other plugs were used, state the character of same and depth placed, from _____ feet to _____ feet for each plug set.

Checked the hole to 4310' and found it open. Filled w/sand to 4300' and dumped 5 sacks of cement with bailer. Pulled 60 jts of casing, and pumped in 30 sacks of gel mud. Pulled rest of casing (54 jts), cleared hole and bailed to 200', set rock bridge to 190' and dumped 20 sacks of cement. Mudded the hole to 40', set rock bridge to 30' and ran 10 sacks of cement to base of cellar.

PLUGGING COMPLETED

RECEIVED
STATE CORPORATION COMMISSION

FEB 10 1959

(If additional description is necessary, use BACK of this sheet)
Name of Plugging Contractor West Supply Co., Inc.
Address Chase, Kansas

STATE OF KANSAS COUNTY OF RICE, ss.
I, Noel J. Knight (employee of owner) or (OWNER OR OPERATOR) of the above-described well, being first duly sworn on oath, says: That I have knowledge of the facts, statements, and matters herein contained and the log of the above-described well as filed and that the same are true and correct. So help me God.

(Signature) Noel J. Knight
Chase, Kansas (Address)

SUBSCRIBED AND SWORN TO before me this 9th day of February, 19 59

2-9-59

Thomas I. Dyer
Notary Public.

My commission expires _____

PLUGGING
FILE SEC 14 T 27 R 10 W
BOOK PAGE 14 LINE 24

WELL LOG BUREAU—KANSAS GEOLOGICAL SOCIETY
 808 East Murdock, Wichita, Kansas

59


Company: BENNETT & ROBERTS OIL OPERATIONS
 Farm: Sale No. 1

SEC. 14 T. 27 R. 10W
 CW/2 SW SW

Total Depth. 4311
 Comm. 10-31-53
 Sh. or Treated.
 Con. Factor.
 Issued. 1-23-54

Comp. 12-30-53

County Kingman KANSAS

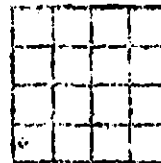

CASING:

8 5/8" 208' cem. w/190 sx
 5 1/2" 4309' cem. w/75 sx

Elevation. 1747

Production. Pmp. 35 BO & 40 BW

Figures indicate Bottom of Formations.

sand	80
sand & shale	160
red bed	208
shale & red bed	235
red bed, shells	400
shale & shells	625
shale blue	885
shale & shells	1005
anhydrite	1025
shale & shells	1330
lime	1360
shale & shells	1385
shale	1400
lime & shale	1555
lime	1825
lime & shale	1995
lime & shale strks	2110
lime	2200
lime & shale	2780
shale	2945
lime & shale	3055
lime	3115
lime & shale	3210
shale	3284
shale & lime	3576
lime	3953
lime & shale	4027
cherty lime	4032
shale & lime	4095
chert & shale	4133
shale & lime	4303
shale	4309
lime	4311
Total Depth	

*All 4 produce.
 Artesian valley pool.*

Tops:	
Heebner	3330
Douglas Sand	3397
Brown Lime	3501
Lansing	3512
Mississippi Chert	4022
Kinderhook	4104
Viola	4309

RECEIVED
 STATE CORPORATION COMMISSION
 FEB 6 1959.
 CONSERVATION DIVISION
 Wichita, Kansas

PLUGGING
 FILE SEC. 14 T. 27 R. 10W
 BOOK PAGE 14 LINE 24