


STATE OF KANSAS
STATE CORPORATION COMMISSION

WELL PLUGGING RECORD

Give All Information Completely
Make Required Affidavit
Mail or Deliver Report to
Conservation Division
State Corporation Comm.
245 North Water
Wichita, KS 67202

Pratt County, Sec. 21 Twp. 27S Rge. 11W E/W
Location as "NE/CNW $\frac{1}{4}$ /SW $\frac{1}{4}$ " or footage from lines _____
NE NW SW
Lease Owner D. R. Lauck Oil Company, Inc.
Lease Name Hammeke "A" Well No. 1
Office Address 221 S. Broadway, Wichita, Kansas
Character of Well (Completed as Oil, Gas or Dry Hole) _____
Dry Hole

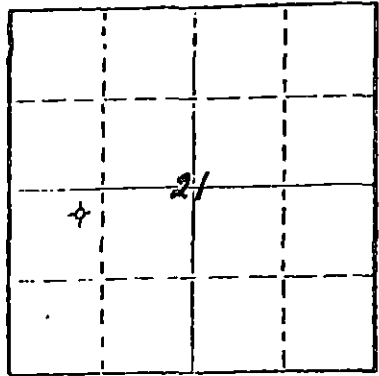

Locate well correctly on above
Section Plat

Date Well completed November 2, 1978
Application for plugging filed November 2, 1978
Application for plugging approved November 2, 1978
Plugging commenced November 2, 1978
Plugging completed November 2, 1978
Reason for abandonment of well or producing formation _____
Dry Hole

If a producing well is abandoned, date of last production _____ 19____

Was permission obtained from the Conservation Division or its agents before plugging was commenced? Yes

Name of Conservation Agent who supervised plugging of this well Wm. T. Owen
Producing formation _____ Depth to top _____ Bottom _____ Total Depth of Well 4475'
Show depth and thickness of all water, oil and gas formations.

OIL, GAS OR WATER RECORDS

CASING RECORD

FORMATION	CONTENT	FROM	TO	SIZE	PUT IN	PULLED OUT
		0'	347'	8-5/8"	340.34'	None

Describe in detail the manner in which the well was plugged, indicating where the mud fluid was placed and the method or methods used in introducing it into the hold. If cement or other plugs were used, state the character of same and depth placed, from _____ feet to _____ feet for each plug set.

RECEIVED
STATE CORPORATION COMMISSION

NOV - 7 1978 11-7-78

Plugged with 40 sacks cement at 600'
40 sacks cement at 330', plug & huls
and 12 sacks cement at 40', 3 sacks
cement in rat hole.

CONSERVATION DIVISION
Wichita, Kansas

(If additional description is necessary, use BACK of this sheet)

Name of Plugging Contractor Allied Cementing Co.

STATE OF KANSAS COUNTY OF SEDGWICK, ss.
John D. Knightley (employee of owner) or (owner or operator)
of the above-described well, being first duly sworn on oath, says: That I have knowledge of the facts, statements, and matters herein contained and the log of the above-described well as filed and that the same are true and correct. So help me God.

(Signature) [Signature]
221 S. Broadway, Wichita, Kansas
(Address)

SUBSCRIBED AND SWORN TO before me this 6th day of November, 1978

[Signature]
Notary Public.

My commission expires March 12, 1979

D. R. Lauck Oil Company, Inc. - Hammeke "A" #1
NE NW SW Sec. 21 - 27S-11W
Pratt County, Kansas

Contractor: D. R. Lauck Oil Company, Inc.
221 S. Broadway, Suite 400
Wichita, Kansas 67202

Commenced: October 22, 1978
Completed: November 2, 1978

Drillers Log

Clay	50
Sand	190
Red Bed	1110
Shale	1690
Shale & Shells	3090
Shale & Lime	3845
Lime & Shale	3904
Lime	4250
Lime & Shale	4330
Lime	4350
Lime & Shale	4385
Lime	4475 RTD

RECEIVED
STATE CORPORATION COMMISSION

NOV - 7 1978

CONSERVATION DIVISION
Wichita, Kansas