


STATE OF KANSAS
STATE CORPORATION COMMISSION

Form CP-4

Give All Information Completely
Make Required Affidavit
Mail or Deliver Report to:
Conservation Division
State Corporation Commission
212 No. Market
Wichita, Kansas

WELL PLUGGING RECORD

Pratt County, Sec. 21 Twp. 27S Rge. (E) 11 (W)
Location as "NE/CNW%SW%" or footage from lines NW SW NE
Lease Owner National Associated Petroleum Company
Lease Name Sawyer Well No. 1
Office Address Fourth Floor Petroleum Bldg., Tulsa, Oklahoma 74103
Character of Well (completed as Oil, Gas or Dry Hole) Oil
Date well completed December 7 1957
Application for plugging filed 19
Application for plugging approved September 3, 1968
Plugging commenced September 4, 1968
Plugging completed 9-10- 3:00 P.M. 1968
Reason for abandonment of well or producing formation Production ceased.

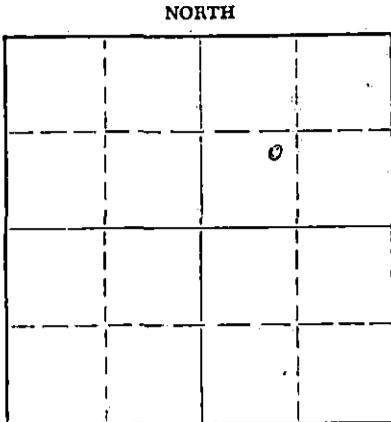

Locate well correctly on above Section Plat

If a producing well is abandoned, date of last production August 1968
Was permission obtained from the Conservation Division or its agents before plugging was commenced? Yes

Name of Conservation Agent who supervised plugging of this well Ralph Warner
Producing formation Lensing Depth to top 3943 Bottom 3949 Total Depth of Well 4530 Feet
Show depth and thickness of all water, oil and gas formations.

OIL, GAS OR WATER RECORDS

CASING RECORD

FORMATION	CONTENT	FROM	TO	SIZE "	PUT IN	PULLED OUT
				<u>8 5/8"</u>	<u>652</u>	<u>NONE</u>
				<u>5 1/2"</u>	<u>4195</u>	<u>2655</u>

Describe in detail the manner in which the well was plugged, indicating where the mud fluid was placed and the method or methods used in introducing it into the hole. If cement or other plugs were used, state the character of same and depth placed, from _____ feet to _____ feet for each plug set.

Chat From 3975 to 3920
5 Sacks Cement From 3920 to 3885
Ripped pipe at 2200 - 2800 and 2650.
Build wood Bridge at 300
Rock From 300 to 290
25 Sacks Cement From 290 to 215
Mud From 215 to 40
Rock From 40 to 30
10 Sacks Cement From 30 to Top

RECEIVED
STATE CORPORATION COMMISSION
NOV 8 1968
CONSERVATION DIVISION
Wichita, Kansas

(If additional description is necessary, use BACK of this sheet)
Name of Plugging Contractor Clarke Corporation
Address Medicine Lodge, Kansas

STATE OF OKLAHOMA, COUNTY OF TULSA, ss.
Forrest H. Lindsay (employee of owner) or (owner or operator) of the above-described well, being first duly sworn on oath, says: That I have knowledge of the facts, statements, and matters herein contained and the log of the above-described well as filed and that the same are true and correct. So help me God.

(Signature) Forrest H. Lindsay
Fourth Floor Petroleum Bldg., Tulsa, Okla.
(Address)

SUBSCRIBED AND SWORN TO before me this 6th day of November, 1968

Sara L. Marsh
Notary Public.

My commission expires December 15, 1968

National Associated Petroleum Company
 Fifth Floor Ritz Building
 NW SW NE, Sec. 21-278-11W
 Pratt County, Kansas
 Swisher No. 1
 Driller's Log

<u>From</u>	<u>To</u>	<u>Formation</u>	<u>Remarks</u>
0	195	Sand	
195	653	Red Bed & Sand	Ran 15 jts. 8-5/8" Casing, set at 653' with 400 sacks cement
653	1610	Shale & Shells	
1610	1635	Shale	
1635	3348	Lime & Shale	
3348	4210	Lime	
4210	4245	Lime & Shale	
4245	4530	Lime	T. D.

RECEIVED
 STATE CORPORATION COMMISSION
 SEP 3 1968
 CONSERVATION DIVISION
 Wichita, Kansas

I certify the above to be a true and exact copy of the Driller's Log as shown by the Daily Drilling Reports.

Badger Drillers, Inc.

J. E. Christian

Subscribed and sworn to before me
 this 26th day of November, 1957

Martha Maher
 Notary Public
 My Commission Expires 6-26-60

