

STATE OF KANSAS
STATE CORPORATION COMMISSION

WELL PLUGGING RECORD

Give All Information Completely
Make Required Affidavit
Mail or Deliver Report to:
Conservation Division
State Corporation Commission
211 No. Broadway
Wichita, Kansas

Pratt County. Sec. 21 Twp. 27 Rge. 11 (E) (W)

Location as "NE/CNWxSWx" or footage from lines SE SE NW

Lease Owner Messman - Rinehart Oil Company

Lease Name Lion Fee Well No. A -1

Office Address Wichita, Kansas

Character of Well (completed as Oil, Gas or Dry Hole)

Date well completed 19

Application for plugging filed 19

Application for plugging approved 19

Plugging commenced 9-23-63 19


Plugging completed 9-26-63 19

Reason for abandonment of well or producing formation Dry

If a producing well is abandoned, date of last production 19

Was permission obtained from the Conservation Division or its agents before plugging was commenced? Yes by Messman - Rinehart Oil Company

NORTH

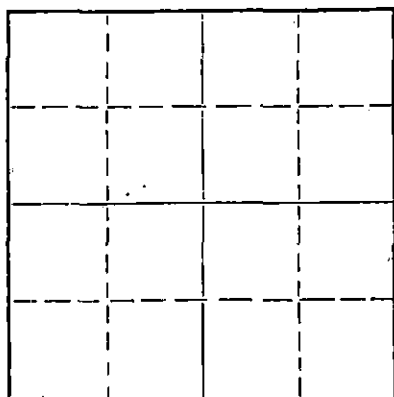

Locate well correctly on above Section Plat

Name of Conservation Agent who supervised plugging of this well Elving

Producing formation Depth to top Bottom Total Depth of Well PB 3975 Feet

Show depth and thickness of all water, oil and gas formations.

OIL, GAS OR WATER RECORDS

CASING RECORD

FORMATION	CONTENT	FROM	TO	SIZE	PUT IN	PULLED OUT
				13 3/8	180	None
				5 1/2	None	3519

Describe in detail the manner in which the well was plugged, indicating where the mud fluid was placed and the method or methods used in introducing it into the hole. If cement or other plugs were used, state the character of same and depth placed, from feet to feet for each plug set.

Cleaning out cellar. Rigged up. Sanded to 3780'. Dumped 5 sacks of cement.

Cut off 13 3/8" pipe. Loaded hole with water. Working pipe. Shot well at 3501'.

Pulling pipe.

Pulling pipe.

Cleaning and doping pipe.

Circulating. Mixing 25 sacks of mud and 20 sacks of cement at 324'. Pumped 25 sacks at 212'. Build rock bridge. Capped well with 20 sacks of cement.

Pulled pipe.

(If additional description is necessary, use BACK of this sheet)

Name of Plugging Contractor Forbes Casing Pulling, Inc.

Address P. O. Box 221 Great Bend, Kansas

STATE OF Kansas COUNTY OF Barton ss. J. O. Forbes (employee of owner) or (owner or operator) of the above-described well, being first duly sworn on oath, says: That I have knowledge of the facts, statements, and matters herein contained and the log of the above-described well as filed and that the same are true and correct. So help me God.

(Signature) J. O. Forbes

P. O. Box 221 Great Bend, Kansas (Address)

SUBSCRIBED AND SWORN TO before me this 2 day of October, 1963

My commission expires May 27, 1964

Notary Public.

RECEIVED
STATE CORPORATION COMMISSION
10-3-63 OCT 3 1963
CONSERVATION DIVISION
Wichita, Kansas

#1 LION PEB MAP

WELL RECORD

Location: SE SE 1/4 21-27-11W
Fruitt County, Kansas

Commenced: January 22, 1954

Operator: Graham-Messman-Rinehart Oil Company
1005 East Second, Wichita, Kansas

Completed:

Elevation: 1794 K.B.

Contractor: Graham-Messman-Rinehart Drilling Co.
1005 East Second, Wichita, Kansas

Production:

Casing record: 19 3/8" @ 120' w/250 sacks cement.
5 1/2" @ 4515' w/ 150 sacks cement.

LOG

Red Sand & Shells			
Shale - Shells	730	Dolomite	4316
Shale - Shells	770	Chert - Lime	4322
Shale	1033	Lime	4332
Shale & Shells	1401	Dolomite	4346
Shale & Lime	1616	Dolomite - Chert - Lime	4365
Lime & Shale	1814	Lime - Chert	4392
Lime & Shale	1961	Simpson Shale	4427
Lime & Shale	2190	Simpson Shale	4486
Lime & Shale	2348	Sand & Arbuckle	4515 T.D.
Lime & Shale	2463		
Lime & Shale	2615		
Lime & Shale	2824		
Lime & Shale	2948		
Lime & Shale	3124		
Lime & Shale	3261		
Lime & Shale	3395		
Lime & Shale	3432		
Lime - Shale & Sand	3552		
Lime - Shale & Sand	3625		
Lime	3714		
Lime	3800		
Lime	3820		
Lime	3835		
Lime	3874		
Lime	3936		
Lime	3975		
Lime	4042		
Lime	4075		
Chert - Lime	4090		
Mississippi - Lime	4151		
Mississippi - Lime	4180		
Randbrook - Shale	4249		
Lime	4277		

TOPS

- Douglas Sand - 3499 (-1705)
- Brown Lime - 3598 (-1804)
- Lansing - 3617 (-1823)
- Mississippi - 4064 (-2270)
- Viola - 4306 (-2512)
- Simpson - 4394 (-2600)
- Arbuckle - 4485 (-2691)

The undersigned, GRAHAM-MESSMAN-RINEHART DRILLING COMPANY, hereby certifies that the above log is a true and correct log of the formation encountered in drilling the above well as reflected by the Daily Drilling Reports.

GRAHAM-MESSMAN-RINEHART DRILLING COMPANY

By: J. A. Gilliland
J. A. Gilliland

Subscribed and sworn to before me this 1st day of March, 1954.

[Signature]
Notary Public

My commission expires: December 1, 1956

GMR
File Copy