


STATE OF KANSAS
STATE CORPORATION COMMISSION

WELL PLUGGING RECORD

Give All Information Completely
Make Required Affidavit
Mail or Deliver Report to:
Conservation Division
State Corporation Commission
800 Bitting Building
Wichita, Kansas

Pratt County, Sec. 21 Twp. 27 Rge. (E) 11(W)

Location as "NE/CNW/SW" or footage from lines NE NE SW
Lease Owner Southwestern Exploration Company
Lease Name Fairchilds Well No. 1
Office Address 352 North Broadway, Wichita 2, Kansas
Character of Well (completed as Oil, Gas or Dry Hole) Dry Hole
Date well completed August 24 19 54
Application for plugging filed August 25 19 54
Application for plugging approved August 24 (Oral) 19 54
Plugging commenced August 24 19 54
Plugging completed August 24 19 54
Reason for abandonment of well or producing formation Dry Hole

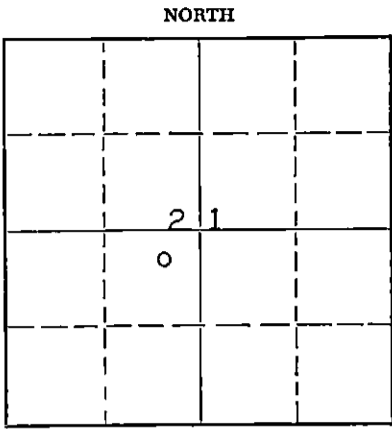

Locate well correctly on above
Section Plat

If a producing well is abandoned, date of last production -- 19 --
Was permission obtained from the Conservation Division or its agents before plugging was commenced? Yes

Name of Conservation Agent who supervised plugging of this well M. A. Rives, Box 148, Pratt, Kansas
Producing formation -- Depth to top -- Bottom -- Total Depth of Well 4332 Feet
Show depth and thickness of all water, oil and gas formations.

OIL, GAS OR WATER RECORDS

CASING RECORD

FORMATION	CONTENT	FROM	TO	SIZE	PUT IN	PULLED OUT
				8-5/8"	681'	None

Describe in detail the manner in which the well was plugged, indicating where the mud fluid was placed and the method or methods used in introducing it into the hole. If cement or other plugs were used, state the character of same and depth placed, from -- feet to -- feet for each plug set.

Filled hole with mud to 300'. Set plug and cemented with 20 sacks cement. Filled hole with mud to 35'. Set plug and cemented with 10 sacks.

RECEIVED
STATE CORPORATION COMMISSION
9-1-54
SEP 1 1954

CONSERVATION DIVISION
Wichita, Kansas

(If additional description is necessary, use BACK of this sheet)
Name of Plugging Contractor Rocket Drilling Company, Inc.
Address 352 North Broadway, Wichita 2, Kansas

STATE OF KANSAS COUNTY OF SEDGWICK, ss.
B. W. Burks (employee of owner) ~~owner~~ of the above-described well, being first duly sworn on oath, says: That I have knowledge of the facts, statements, and matters herein contained and the log of the above-described well as filed and that the same are true and correct. So help me God.
(Signature) B. W. Burks
352 North Broadway, Wichita 2, Kansas (Address)

SUBSCRIBED AND SWORN TO before me this 30th day of August 19 54
Patricia Mae Blume Notary Public.

My commission expires March 5, 1958

PLUGGING
W21 SEC 21 T27 R11W
BOOK PAGE 59 LINE 7



DRILLING COMPANY, INC. Phone 3-1279 352 N. BROADWAY WICHITA, KANSAS

#1 Fairchilds
NE NE SW, 21-27-11W
Pratt County, Kansas

Southwestern Exploration Company
503 Union National Bank Building
Wichita 2, Kansas

Elevation: 1778 R.B.
Spudded: August 4, 1954
Rotary Completed: August 24, 1954
Initial Production: Dry and Abandoned
Contractor: Rocket Drilling Company, Inc.

CASING RECORD

681' 8-5/8" O.D. 24# Seamless Casing cemented with 300 sacks cement.
5-1/2" - None

DRILLERS LOG

Gravel	0 to 129	Sand	1930
Red Shale	445	Lime	2280
Red Shale & Shells	530	Lime & Shale	3160
Sand	565	Lime	3220
Red Shale & Sand Streaks	681	Lime & Shale	3623
Shale & Shells	1150	Lime	4076
Salt, Shale & Lime	1590	Chert	4103
Lime & Shale	1725	Lime & Chert	4136
Lime	1795	Lime	4179
Sand	1810	Shale	4300
Lime	1920	Viola	4332 TD

STATE OF KANSAS)
) SS:
COUNTY OF SEDGWICK)

I hereby certify that to the best of my knowledge and belief, the foregoing log is true and correct.

ROCKET DRILLING COMPANY, INC.

By B. W. Burks
B. W. Burks

Subscribed and sworn to before me, a Notary Public, in and for the state and county aforesaid, this 25th day of August, 1954.

My commission expires March 5, 1958

Patricia M. ...
Notary Public
AUG 27 1954

PLUGGING
FILE SEC 21 T 27 R 11W
BOOK PAGE 59 LINE 2

REGISTRATION DIVISION
Kansas