


WELL PLUGGING RECORD

All Information Completely
Make Required Affidavit
Mail or Deliver Report to:
Conservation Division
State Corporation Commission
211 No. Broadway
Wichita, Kansas

Pratt County, Sec. 21, Twp. 27S, Rge. (E) 11 (W)

Location as "NE/CNW/SW" or footage from lines NE NE SW
Lease Owner James A. Hershberger
Lease Name Fairchild Well No. 1
Office Address 1039 First National Bank Bldg., Wichita, Kansas
Character of Well (completed as Oil, Gas or Dry Hole) oil
Date well completed 19 63
Application for plugging filed July 9 19 63
Application for plugging approved 19 63
Plugging commenced July 11 19 63
Plugging completed July 13 19 63
Reason for abandonment of well or producing formation depleted

NORTH

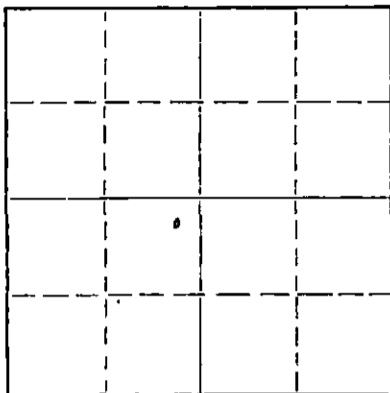

Locate well correctly on above
Section Plat

If a producing well is abandoned, date of last production 19
Was permission obtained from the Conservation Division or its agents before plugging was commenced? yes

Name of Conservation Agent who supervised plugging of this well Herman E. Justus
Producing formation Depth to top Bottom Total Depth of Well 4335 Feet
Show depth and thickness of all water, oil and gas formations.

OIL, GAS OR WATER RECORDS

CASING RECORD

FORMATION	CONTENT	FROM	TO	SIZE	PUT IN	PULLED OUT
		0	681	8 5/8"	681	none
		0	3990	4 1/2"	3990	3322.60

Describe in detail the manner in which the well was plugged, indicating where the mud fluid was placed and the method or methods used in introducing it into the hole. If cement or other plugs were used, state the character of same and depth placed, from feet to feet for each plug set.

Pushed plug to 3750'. Set 10' rock bridge. Mixed 4 sacks of cement and dumped at 3740'. Mud back to 250', set 10' rock bridge and dump 20 sacks of cement. Fill with mud to 40', set 10' rock bridge and cap with 10 sacks of cement. Plugged 6 p.m.

RECEIVED
STATE CORPORATION COMMISSION

JUL 23 1963

CONSERVATION DIVISION
Wichita, Kansas

(If additional description is necessary, use BACK of this sheet)

Name of Plugging Contractor Pipe Pullers, Inc.
Address Box 486, Ellinwood, Kansas

STATE OF Kansas, COUNTY OF Barton, ss.
Dean Wells (employee of owner) or (owner or operator) of the above-described well, being first duly sworn on oath, says: That I have knowledge of the facts, statements, and matters herein contained and the log of the above-described well as filed and that the same are true and correct. So help me God.

(Signature) [Signature]
Ellinwood, Kansas (Address)

SUBSCRIBED AND SWORN to before me this 15th day of July, 19 63

My commission expires Feb. 10, 1967

[Signature] Notary Public

No drillers log. This was an old well
workover.

RECEIVED
STATE CORPORATION COMMISSION

JUL 23 1963

CONSERVATION DIVISION
Wichita, Kansas

100-100000-100000

Faint, illegible text, possibly bleed-through from the reverse side of the page.

STATE CORPORATION COMMISSION

CONSERVATION DIVISION

Faint, illegible text, possibly bleed-through from the reverse side of the page.

Faint, illegible text, possibly bleed-through from the reverse side of the page.