


STATE OF KANSAS  
STATE CORPORATION COMMISSION

WELL PLUGGING RECORD

Give All Information Completely  
Make Required Affidavit  
Mail or Deliver Report to:  
Conservation Division  
State Corporation Commission  
212 North Market, Insurance Bldg.  
Wichita, Kansas.

Pratt County. Sec. 14 Twp. 27 S Rge. (E) 11 (W)  
Location as "NE/CNW/SW" or footage from lines NW/4 SW/4 SW/4  
Lease Owner Messman-Rinehart Oil Company  
Lease Name Park Well No. 2  
Office Address 518 Petroleum Building, Wichita, Kansas  
Character of Well (completed as Oil, Gas or Dry Hole) Dry Hole  
Date well completed May 1 1959  
Application for plugging filed February 12 1960  
Application for plugging approved February 19 1960  
Plugging commenced March 21 1960  
Plugging completed March 25 1960  
Reason for abandonment of well or producing formation Dry

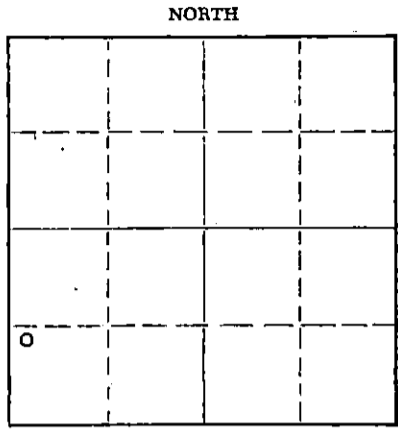

Locate well correctly on above Section Plat

If a producing well is abandoned, date of last production 19  
Was permission obtained from the Conservation Division or its agents before plugging was commenced? yes

Name of Conservation Agent who supervised plugging of this well Fred Hampel, Pretty Prairie, Kansas  
Producing formation \_\_\_\_\_ Depth to top \_\_\_\_\_ Bottom \_\_\_\_\_ Total Depth of Well 4115 Feet  
Show depth and thickness of all water, oil and gas formations.

OIL, GAS OR WATER RECORDS

CASING RECORD

FORMATION	CONTENT	FROM	TO	SIZE	PUT IN	PULLED OUT
				10-3/4"	300'	none
				4-1/2"	4104'	3425'

Describe in detail the manner in which the well was plugged, indicating where the mud fluid was placed and the method or methods used in introducing it into the hole. If cement or other plugs were used, state the character of same and depth placed, from \_\_\_\_\_ feet to \_\_\_\_\_ feet for each plug set.

Filled back with sand from 3880 ft. to 3790 ft., mixed and ran sand with water., mixed and ran 4 sx. cement with dump bailer, set <sup>rock</sup> bridge at 295 ft. with 25 sx. cement, Mud to 35 ft., set rock bridge and 35 ft. with 15 sx. cement to base of cellar

RECEIVED  
STATE CORPORATION COMMISSION

4-25-60 APR 25 1960

CONSERVATION DIVISION  
Wichita, Kansas

(If additional description is necessary, use BACK of this sheet)

Name of Plugging Contractor Southwest Casing Pulling Co., Inc. - License No. 12  
Address P. O. Box 364, Great Bend, Kansas

STATE OF Kansas COUNTY OF Sedgwick, ss.  
J. A. Gilliland (employee of owner) or ~~owner~~ or ~~operator~~ of the above-described well, being first duly sworn on oath, says: That I have knowledge of the facts, statements, and matters herein contained and the log of the above-described well as filed and that the same are true and correct. So help me, God.

(Signature) J. A. Gilliland  
518 Petroleum Building, Wichita, Kansas  
(Address)

SUBSCRIBED AND SWORN TO before me this 21st day of April, 1960

Barbara J. Scott  
Barbara J. Scott Notary Public.

My commission expires December 1, 1960



NO. 2 PARK

Well Record

Location: NW SW SW, Sec. 14-278-11W  
Pratt County, Kansas

Operator: Hessman-Rinehart Oil Company  
518 Petroleum Building  
Wichita, Kansas

Contractor: Hessman-Rinehart Oil Company  
518 Petroleum Building  
Wichita, Kansas

Casing record: 10-3/4" @ 300' w/200 sq. cm.  
4-1/2" @ 4104' 2/150 sq. cm.

Commenced: April 9, 1959  
Completed: April 22, 1959  
(rotary)  
Elevation: 1810' K/B  
Production: D & A

\*\*\* LOG \*\*\*

Clay and Soil	50
Sand	150
Shale & Red Bed	200
Red Bed	300
Shale & Red Bed	1140
Shale & Shells	1340
Anhydrite streaks	1380
Shale	1510
Lime & Shale	1650
Lime	1970
Lime & Shale	2730
Shale	2770
Lime	2845
Lime	2910
Lime & Shale	2930
Lime	3344
Lime & Shale	3460
Shale	3590
Lime & Shale	3640
Lime	3717
Lime & Shale	3747
Lime	3815
Lime & Shale	3840
Lime	3900
Lime & Shale	4060
Lime	4085
Cherty Lime	4115 R.T.D.

Sample Tops:

3430' - Heabner (-1620)  
3609' - Brown Lime (-1799)  
3627' - Lansing (-1817)  
4099' - Mississippi "Chat" (-2289)

RECEIVED  
STATE CORPORATION COMMISSION

APR 25 1960

CONSERVATION DIVISION  
Wichita, Kansas

The undersigned, HESSMAN-RINEHART OIL COMPANY, hereby certifies that the above log is a true and correct log of the formation encountered in drilling the above well as reflected by the Daily Drilling Reports.

HESSMAN-RINEHART OIL COMPANY

By: J. A. Gilliland  
J. A. Gilliland

Subscribed and sworn to before me this  
20th day of May, 1959.

Barbara J. Scott  
Barbara J. Scott, Notary Public

My Commission Expires: December 1, 1960

COMPLETION DATA

Hessman-Rinehart Oil Company  
No. 2 Park  
NW SW SW, Sec. 14-275-11W  
Pratt County, Kansas

4-27-59 Moved in cable tools, Perf. 3942-46' w/4<sup>s</sup> per ft., show oil and gas on gun  
4-28-59 Treated with 1000 gal. acid, made  $\frac{1}{2}$  BOPH (show gas and no wtr.)  
Set plug @ 3850', Perf. 3812-16' w/4<sup>s</sup> per ft. (jet)  
4-29-59 Sudd. 20 gal. oil and 5 $\frac{1}{2}$  bbbls. wtr. in 30 min.  
Treated with 500 gal. acid  
4-30-59 Set overnight and tested 3 bbbls. oil and 3 $\frac{1}{2}$  bbbls. wtr.  
5-1-59 Tested 8 bbbls. oil and 136 bbbls. wtr. in 12 hrs.  
Temporarily abandoned.

MESSEMAN-RINEHART OIL COMPANY

By:   
Roger L. Messman, Partner

RLM/bjs

RECEIVED  
STATE CORPORATION COMMISSION

APR 25 1960

CONSERVATION DIVISION  
Wichita, Kansas