


STATE OF KANSAS
STATE CORPORATION COMMISSION

WELL PLUGGING RECORD

Give All Information Completely
Make Required Affidavit
Mail or Deliver Report to
Conservation Division
State Corporation Comm.
245 North Water
Wichita, KS 67202

Pratt County. Sec. 14 Twp. 27S Rge. 11W&W
Location as "NE/CNW $\frac{1}{4}$ SW $\frac{1}{4}$ " or footage from lines _____

C NE SW
Lease Owner Hummon Oil Company
Lease Name Park Well No. 1
Office Address 1725 Vickers-KSB&T Bldg., Wichita, Ks.
Character of Well (Completed as Oil, Gas or Dry Hole) _____

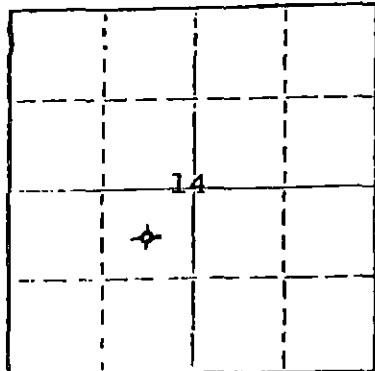

Locate well correctly on above
Section Plat

Dry Hole
Date Well completed November 13, 1978
Application for plugging filed November 13, 1978
Application for plugging approved November 13, 1978
Plugging commenced November 13, 1978
Plugging completed November 13, 1978
Reason for abandonment of well or producing formation _____

Dry Hole
If a producing well is abandoned, date of last production _____ 19____

Was permission obtained from the Conservation Division or its agents before plugging was commenced? Yes

Name of Conservation Agent who supervised plugging of this well Wm. T. Owen
Producing formation _____ Depth to top _____ Bottom _____ Total Depth of Well 4150'
Show depth and thickness of all water, oil and gas formations.

OIL, GAS OR WATER RECORDS

CASING RECORD

FORMATION	CONTENT	FROM	TO	SIZE	PUT IN	PULLED OUT
		0'	322'	8-5/8"	315.81'	None

Describe in detail the manner in which the well was plugged, indicating where the mud fluid was placed and the method or methods used in introducing it into the hold. If cement or other plugs were used, state the character of same and depth placed, from _____ feet to _____ feet for each plug set.

Plugged with 50 sacks cement at 540',
40 sacks cement at 320', 12 sacks cement
at 40', and 3 sacks cement in rat hole.

RECEIVED
STATE CORPORATION COMMISSION

NOV 29 1978
11-29-78

(If additional description is necessary, use BACK of CASE SHEET)
Name of Plugging Contractor Allied Cementing Co.

STATE OF KANSAS COUNTY OF SEDGWICK, ss.
John D. Knightley Agent (employee of owner) or (owner or operator)
of the above-described well, being first duly sworn on oath, says: That I have knowledge of the facts, statements, and matters herein contained and the log of the above-described well as filed and that the same are true and correct. So help me God.

(Signature) [Signature]
221 S. Broadway, Wichita, Kansas
(Address)

SUBSCRIBED AND SWORN TO before me this 28th day of November, 1978

[Signature]
Notary Public.

My commission expires March 12, 1979

Hummon Oil Company - Park #1
C NE SW Sec. 14-27S-11W
Pratt County, Kansas

Contractor: D. R. Lauck Oil Company, Inc.
221 S. Broadway, Suite 400
Wichita, Kansas 67202

Commenced: November 3, 1978
Completed: November 13, 1978

Drillers Log

Sand	167
Red Bed	1060
Shale	1530
Shale & Shells	1655
Shale	1890
Shale & Shells	2814
Shale & Lime	2920
Shells	3140
Shale	3250
Shale & Lime	3450
Lime	4150 RTD

RECEIVED
STATE CORPORATION COMMISSION

NOV 29 1978

CONSERVATION DIVISION
Wichita, Kansas