


STATE OF KANSAS
STATE CORPORATION COMMISSION

Form CP-4

Give All Information Completely
Make Required Affidavit
Mail or Deliver Report to:
Conservation Division
State Corporation Commission
212 No. Market
Wichita, Kansas 67202

WELL PLUGGING RECORD

Pratt County. Sec. 14 Twp. 27 Rge. 11 (E) W (W)
Location as "NE/CNW/SW" or footage from lines NE NW SE
Lease Owner Messman - Rinehart Oil Co.
Lease Name Parks Well No. # 3
Office Address 1432 Wichita Plaza ; Wichita, Ks. 67202
Character of Well (completed as Oil, Gas or Dry Hole) _____
Date well completed _____ 19____
Application for plugging filed November 1971
Application for plugging approved November 1971
Plugging commenced December 9 1971
Plugging completed December 22 1971
Reason for abandonment of well or producing formation _____

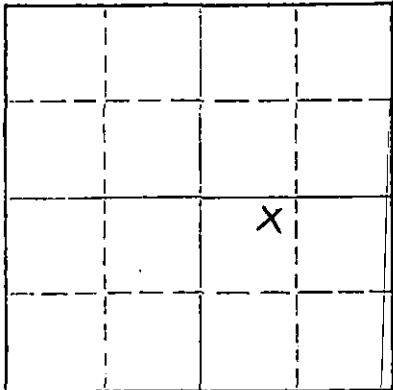

Locate well correctly on above
Section Plat

If a producing well is abandoned, date of last production _____ 19____
Was permission obtained from the Conservation Division or its agents before plugging was commenced? Yes

Name of Conservation Agent who supervised plugging of this well Russell Biberstein
Producing formation _____ Depth to top _____ Bottom _____ Total Depth of Well _____ Feet
Show depth and thickness of all water, oil and gas formations.

OIL, GAS OR WATER RECORDS

CASING RECORD

FORMATION	CONTENT	FROM	TO	SIZE	PUT IN	PULLED OUT
				10 3/4"	274	None
				4 1/2"	3861	3010

Describe in detail the manner in which the well was plugged, indicating where the mud fluid was placed and the method or methods used in introducing it into the hole. If cement or other plugs were used, state the character of same and depth placed, from _____ feet to _____ feet for each plug set.

December 9, 1971 Plugged off bottom. Dumped sand to 3800'. Mixed and dumped 4 sx of cement to 3750'.
December 22, 1971 Plugged off top. Set 20' rock bridge at 260'. Filled 10 3/4" surface casing from 260' to base of cellar with 3000 lb. P.S.I. ready-mix concrete.

RECEIVED
STATE CORPORATION COMMISSION
JAN 20 1972
CONSERVATION DIVISION
Wichita, Kansas

(If additional description is necessary, use BACK of this sheet)
Name of Plugging Contractor RUSS CASING PULLING, INC.
Address P. O. BOX 1082 ; GREAT BEND, KANSAS 67530

STATE OF Kansas, COUNTY OF Sedgwick, ss.
J. A. Gilliland (employee of owner) or ~~owner~~ of the above-described well, being first duly sworn on oath, says: That I have knowledge of the facts, statements, and matters herein contained and the log of the above-described well as filed and that the same are true and correct. So help me God. MESSMAN-RINEHART OIL COMPANY

(Signature) J. A. Gilliland
J. A. Gilliland, Office Manager
1432 Wichita Plaza, Wichita, Kansas 67202
(Address)

My commission expires to before me this 7th. day of January, 19 72
August 26, 1973
Arlene L. Sloop Notary Public.



NO. 3 PARK

Well Record:

Location: Ctr. E/2 NW/4 SE/4
Section 14-27S-11W
Pratt County, Kansas

Operator: Messman-Rinehart Oil Company
518 Petroleum Building
Wichita, Kansas

Contractor: Messman-Rinehart Oil Company
518 Petroleum Building
Wichita, Kansas

Casing Record: 10-3/4" @ 274' w/230 sx. cem.
4-1/2" @ 3861' w/50 sx. cem.

Commenced: September 22, 1961

Completed: October 4, 1961
(Rotary)

Elevation: 1807' R/B

Production: Oil

*** LOG ***

Sand	155
Shale & Red Bed	274
Red Bed	600
Shale & Shells	1250
Shale & Salt	1300
Shale	1305
Anhydrite	1307
Shale & Shells	1635
Lime & Shale Streaks	1730
Lime & Shale	1830
Lime	1975
Lime & Shale	2785
Shaley Lime	2870
Lime & Shale	3165
Chalkey Lime & Shale Streaks	3274
Lime & Shale	3485
Shale & Lime	3610
Lime	3954 R.T.D.

Sample Tops:

3427' - Heebner (-1620)
3611' - Brown Lime (-1804)
3636' - Lansing (-1829)

RECEIVED
STATE CORPORATION COMMISSION
JAN 20 1972
CONSERVATION DIVISION
Wichita, Kansas

The undersigned, MESSMAN-RINEHART OIL COMPANY, hereby certifies that the above log is a true and correct log of the formation encountered in drilling the above well as reflected by the Daily Drilling Reports.

MESSMAN-RINEHART OIL COMPANY

By: J. A. Gilliland

J. A. Gilliland

Subscribed and sworn to before me this
20th day of October, 1961.

Barbara J. Scott
Barbara J. Scott, Notary Public

My Commission Expires: December 1, 1964

COMPLETION DATA

Messman-Rinehart Oil Company
No. 3 Park
Ctr. E/2 NW SE, Sec. 14-27S-11W
Pratt County, Kansas

- 10/12/61 - Moved in cable tools, Ran Welex Radio-activity Log
Perf. 3810-14' w/4⁹ ft., ran tubing to acidize
- 10/13/61 - Treated with 500 gal. mud acid, swabbed back load through
tubing
- Swab tests - 1st hr. - swbd. 10 bbls. fluid (50% wtr.)
2nd hr. - swbd. 10 bbls. fluid (55% wtr.)
3rd hr. - swbd. 10 bbls. fluid (3 bbls. wtr.
and 7 bbls. oil)
4th hr. - swad. 10 bbls. fluid (7 bbls. wtr.
and 3 bbls. oil)
- Put on pump and pumped 20 bbls. oil and 35 bbls. wtr./day
- 10/22/61 - Pumped 26 bbls. oil and 41 bbls. wtr. per day
- 10/23/61 - Pumped 26 bbls. oil and 41 bbls. wtr. per day
- 10/24/61 - Pumped 26 bbls. oil and 41 bbls. wtr. per day

MESSMAN-RINEHART OIL COMPANY

By: 

Roger L. Messman, Partner

RLW/bjs
10/25/61

RECEIVED
STATE CORPORATION COMMISSION
JAN 20 1972
CONSERVATION DIVISION
Wichita, Kansas