


# WELL PLUGGING RECORD

STATE OF KANSAS  
 STATE CORPORATION COMMISSION  
 Give All Information Completely  
 Make Required Affidavit  
 Mail or Deliver Report to:  
 Conservation Division  
 State Corporation Commission  
 211 No. Broadway  
 Wichita, Kansas

Kingman County. Sec. 14 Twp. 27S Rge. (E) 10 (W)  
 Location as "NE/CNW/SW" or footage from lines Ctr. SW/4 SW/4 SE/4  
 Lease Owner Monsanto Chemical Company (Lion Oil Company Division)  
 Lease Name Bick Well No. 6  
 Office Address P. O. Box 580 Pratt, Kansas  
 Character of Well (completed as Oil, Gas or Dry Hole) Dry Hole  
 Date well completed October 14, 1951  
 Application for plugging filed November 5, 1956  
 Application for plugging approved November 6, 1956  
 Plugging commenced November 25, 1956  
 Plugging completed November 25, 1956  
 Reason for abandonment of well or producing formation Dry Hole

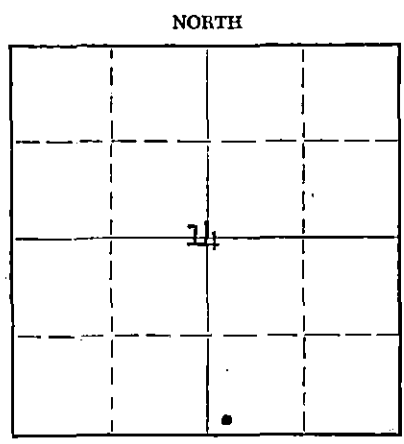

Locate well correctly on above Section Plat

If a producing well is abandoned, date of last production \_\_\_\_\_ 19\_\_\_\_  
 Was permission obtained from the Conservation Division or its agents before plugging was commenced? Yes

Name of Conservation Agent who supervised plugging of this well Mr. M. A. Rives  
 Producing formation none Depth to top \_\_\_\_\_ Bottom \_\_\_\_\_ Total Depth of Well 3502 Feet  
 Show depth and thickness of all water, oil and gas formations.

### OIL, GAS OR WATER RECORDS

### CASING RECORD

FORMATION	CONTENT	FROM	TO	SIZE	PUT IN	PULLED OUT
none				9-5/8"	270'	none
				5-1/2"	4260'	2216'

Describe in detail the manner in which the well was plugged, indicating where the mud fluid was placed and the method or methods used in introducing it into the hole. If cement or other plugs were used, state the character of same and depth placed, from \_\_\_\_\_ feet to \_\_\_\_\_ feet for each plug set.

Plugged with sand from 3502' to 3480' with 5 sacks of cement on top of sand. Shot Pipe off at 2216' and pulled 30 joints. Circulated heavy mud using 21 sacks. Finished pulling casing. Set rock plug at 250' with 20 sacks cement on top of plug. Heavy mud to 35' and set rock plug at 35' with 10 sacks cement to base of cellar.

(If additional description is necessary, use BACK of this sheet)  
 Name of Plugging Contractor West Supply Company  
 Address Chase, Kansas

STATE OF KANSAS COUNTY OF PRATT, ss.  
 I, J. B. Gibbs (employee of owner) or (owner or operator) of the above-described well, being first duly sworn on oath, says: That I have knowledge of the facts, statements, and matters herein contained and the log of the above-described well as filed and that the same are true and correct. So help me God.

(Signature) [Signature]  
 Production Superintendent  
 P. O. Box 580 Pratt, Kansas  
 (Address)

SUBSCRIBED AND SWORN TO before me this 26 th day of November, 1956

My commission expires September 19, 1959

[Signature]  
 Notary Public.

**PLUGGING**  
 FILE SEC 14 T 27 R 10W  
 BOOK PAGE 113 LI E. 33

RECEIVED  
 CORPORATION COMMISSION  
 1956 11-27-56  
 CONSERVATION DIVISION  
 Wichita, Kansas

CTR. OF SW SW SE  
SEC. 14-27S-10W  
KINGMAN COUNTY, KANSAS

BICK WELL NO. 6

CONTRACTOR: THE R. W. RINE DRILLING COMPANY  
STARTED: SEPTEMBER 19, 1951

FINISHED: OCTOBER 1, 1951

LOG

TOP SOIL AND SAND	0 - 40	
SAND AND CLAY	40 - 145	
RED ROCK AND SHELLS	145 - 275	9-5/8" Csg. @ 270' w/150 Sx.
RED ROCK AND SHALE	275 - 700	Syfo @ 500' - 10'
SHALE AND SHELLS	700 - 1340	Syfo @ 1000' - 10'
SHALE AND SHELLS	1340 - 1380	
LIME	1380 - 1540	Syfo @ 1500' - 10'
LIME	1540 - 1765	
LIME AND SHALE	1765 - 1940	
SHALE	1940 - 2643	Syfo @ 2000' - 20' - Syfo @ 2500' - 10'
LIME AND SHALE	2643 - 3090	Syfo @ 3000' - OK
LIME AND SAND	3090 - 3165	
LIME AND SHALE	3165 - 3437	
LIME AND SHALE	3437 - 3535	Syfo @ 3500' - 10'
LIME	3535 - 3710	
LIME	3710 - 3915	
LIME AND SHALE	3915 - 3980	
SHALE AND LIME	3980 - 4000	Syfo @ 4000' - OK
LIME AND CHERT	4000 - 4057	
LIME AND SHALE	4057 - 4125	
SHALE	4125 - 4268	T.D. 5 1/2" Csg. @ 4267' w/200 Sx.

STATE OF KANSAS )  
                          ) ss.  
COUNTY OF SEDGWICK )

I, R. M. GREEN, DO HEREBY CERTIFY THAT THE ABOVE IS A TRUE AND ACCURATE LOG OF THE BICK WELL NO. 6, LOCATED CTR. OF SW SE SE, SEC. 14-27S-10W, KINGMAN COUNTY, KANSAS.

*R. M. Green*  
ASSISTANT SECRETARY

SUBSCRIBED TO AND SWORN BEFORE ME THIS 9TH DAY OF OCTOBER, 1951.

*Leonal Pederson*  
NOTARY PUBLIC

MY COMMISSION EXPIRES APRIL 20, 1955

RECEIVED  
STATE CORPORATION COMMISSION  
NOV - 6 1956  
CONSERVATION DIVISION  
Wichita, Kansas

PLUGGING  
FILE SEC 14 T. 27 R. 10W  
BOOK PAGE 113 LINE 33