

STATE OF KANSAS
- STATE CORPORATION COMMISSION

WELL PLUGGING RECORD

Give All Information Completely
Make Required Affidavit
Mail or Deliver Report to:
Conservation Division
State Corporation Commission
212 North Market, Insurance Bldg.
Wichita, Kansas

Pratt County. Sec. 26 Twp. 29S Rge. (E) 13 (W)

Location as "NE/CNW%SW%" or footage from lines Center SE-NW-NW

Lease Owner Amerada Petroleum Corporation

Lease Name J.W. Combs Well No. 2

Office Address Box 197, Great Bend, Kansas

Character of Well (completed as Oil, Gas or Dry Hole) Dry Hole

Date well completed 1-26- 19 61

Application for plugging filed 1-27- 19 61

Application for plugging approved 1-27- 19 61


Plugging commenced 1:30 PM 1-27- 19 61

Plugging completed 3:30 PM 1-27- 19 61

Reason for abandonment of well or producing formation Dry Hole

If a producing well is abandoned, date of last production - 19 -

Was permission obtained from the Conservation Division or its agents before plugging was commenced? Yes

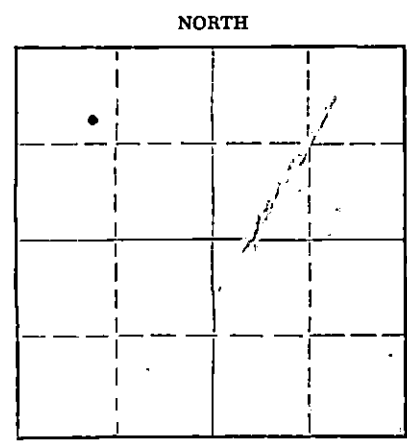

Locate well correctly on above Section Plat

Name of Conservation Agent who supervised plugging of this well W.L. Lackamp

Producing formation - Depth to top - Bottom - Total Depth of Well 4671 Feet

Show depth and thickness of all water, oil and gas formations.

OIL, GAS OR WATER RECORDS

CASING RECORD

FORMATION	CONTENT	FROM	TO	SIZE	PUT IN	PULLED OUT
				8-5/8"	952'	None

Describe in detail the manner in which the well was plugged, indicating where the mud fluid was placed and the method or methods used in introducing it into the hole. If cement or other plugs were used, state the character of same and depth placed, from _____ feet to _____ feet for each plug set.

Filled hole with heavy mud to 952'
Spotted Cement Plug from 952' to 925' w/10 Sacks Cement.
Filled hole with heavy mud to 900'.
Spotted Cement Plug from 900' to 873' w/10 Sacks Cement.
Filled hole with heavy mud from 873' to 350'.
Spotted Cement Plug from 350' to 296' w/20 Sacks Cement.
Filled hole with heavy mud from 296' to 35'.
Spotted Cement plug from 35' to top w/15 Sacks Cement.

RECEIVED
STATE CORPORATION COMMISSION

FEB 2 1961

CONSERVATION DIVISION
Wichita, Kansas

02-02-61

(If additional description is necessary, use BACK of this sheet)

Name of Plugging Contractor Barbour Drilling Company
Address 1579 East 21st - Tulsa, Oklahoma

STATE OF Kansas, COUNTY OF Barton, ss.

A.D. Simpson (employee of owner) of the above-described well, being first duly sworn on oath, says: That I have knowledge of the facts, statements, and matters herein contained and the log of the above-described well as filed and that the same are true and correct. So help me God.

(Signature) A.D. Simpson

Box 197, Great Bend, Kansas
(Address)

SUBSCRIBED AND SWORN TO before me this 30th day of January 19 61

Charles W. Simpson
Notary Public.

My commission expires November 21, 1961

J.W. Combs Well No. 2

C-SE-NW-NW
Pratt County, Kansas
Amerada Petroleum Corporation

8-5/8" OD Casing Cement at 952'

Drilling Commenced 1-7-61
Drilling Completed 1-26-61

FROM	TO	FORMATION	REMARKS
0'	70'	Clay and Sand	
70'	140'	Sand	
140'	425'	Red Bed and Shale	
425'	780'	Shale and Sand	
780'	956'	Shale	
956'	1190'	Red Bed and Shale	
1190'	1800'	Shale and Shells	
1800'	1815'	Lime and Shale	
1815'	1970'	Shale and Lime	
1970'	2185'	Lime	
2185'	2745'	Lime and Shale	
2745'	2910'	Shale	
2910'	3110'	Shale and Lime	
3110'	3225'	Lime and Shale	
3225'	3340'	Shale and Sand	
3340'	3410'	Shale and Lime	
3410'	3635'	Lime	
3635'	3725'	Lime and Shale	
3725'	3870'	Shale and Lime	
3870'	4302'	Lime	
4302'	4340'	Conglomerate Chert	
4340'	4435'	Shale and Lime	
4435'	4450'	Lime	
4450'	4469'	Lime and Chert	
4469'	4525'	Chert and Lime	
4525'	4557'	Lime, Shale and Sand	
4557'	4563'	Sand	
4563'	4600'	Sand and Shale	
4600'	4627'	Shale and Sand	
4627'	4671'	Lime	
	4671'	Total Depth	

RECEIVED
STATE CONSERVATION COMMISSION

FEB 2 1961

CONSERVATION DIVISION
Wichita, Kansas

This is a true copy of the driller's log shown on the drilling tickets.

Amerada Petroleum Corporation

BY: *A.D. Simpson*

A.D. Simpson

Subscribed and sworn to before me on this 27th Day of January 1961.

My Commission Expires November 21, 1961

Charles W. Anderson