


STATE OF KANSAS
STATE CORPORATION COMMISSION

WELL PLUGGING RECORD

Give All Information Completely
Make Required Affidavit
Mail or Deliver Report to
Conservation Division
State Corporation Comm.
245 North Water
Wichita, KS 67202

Pratt County, Sec. 26 Twp. 29 Rge. 13 E/W
Location as "NE/CNW 1/4 SW 1/4" or footage from lines
NW/NW/SW

Lease Owner White Hawk Oil Company
Lease Name Larrison Well No. 4
Office Address Box 1150, Great Bend, Kansas 67530
Character of Well (Completed as Oil, Gas or Dry Hole)

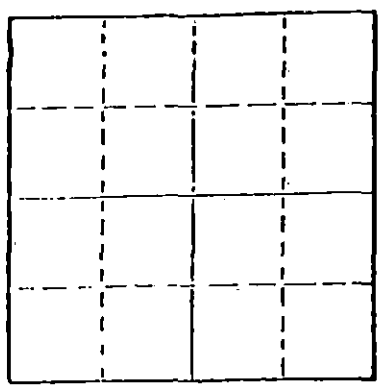

Locate well correctly on above
Section Plot

Date Well completed 19
Application for plugging filed 19
Application for plugging approved 19
Plugging commenced March 21 1978
Plugging completed March 31 1978
Reason for abandonment of well or producing formation

Depleted
If a producing well is abandoned, date of last production 19

Was permission obtained from the Conservation Division or
its agents before plugging was commenced? yes

Name of Conservation Agent who supervised plugging of this well William T. Owen
Producing formation Depth to top Bottom Total Depth of Well 4625'
Show depth and thickness of all water, oil and gas formations.

OIL, GAS OR WATER RECORDS

CASING RECORD

FORMATION	CONTENT	FROM	TO	SIZE	PUT IN	PULLED OUT
				8 5/8"	920'	none
				5 1/2"	4574'	3,271.11'

Describe in detail the manner in which the well was plugged, indicating where the mud fluid
was placed and the method or methods used in introducing it into the hold. If cement or other
plugs were used, state the character of same and depth placed, from feet to
feet for each plug set.

Dumped sand to 4540' and 5 sacks of cement.
Shot pipe at 3700', 3500' and 3300'.
Spotted 40 bbl. oil.
Pulled 103 joints 5 1/2" casing.
Push plug to 400' built a 25' rock bridge and dumped 6 yards ready mix concrete.

(If additional description is necessary, use back of this sheet)
Name of Plugging Contractor Rockhold Engineering, Inc.

STATE OF Kansas COUNTY OF Barton, ss.
James W. Rockhold (employee of owner) or (owner or operator)

of the above-described well, being first duly sworn on oath, says: That I have knowledge of
the facts, statements, and matters herein contained and the log of the above-described well
as filed and that the same are true and correct. So help me God.

(Signature) James W. Rockhold
P. O. Box 698, Great Bend, Kansas 67530
(Address)

SUBSCRIBED AND SWORN TO before me this 3 day of April, 1978

Anita L. Bogle
Notary Public.

My commission expires

ANITA L. BOGLE
Barton County, Kansas
My Appt. Exp. 11/21/81

RECEIVED
STATE CORPORATION COMMISSION
APR 04 1978

09-04-78

CONSERVATION DIVISION
Wichita, Kansas
Barton

D R I L L E R S L O G

#4 Larrison

CASING RECORD: 915.60' of 8-5/8" surface casing COMPANY: Natural Gas & Oil Co. DESCRIPTION: NW NW SW Section 26-29S-13W Pratt County, Kansas

CONTRACTOR: Strata Drilling, Inc.

TOTAL DEPTH: 4575' COMMENCED: October 17, 1960
 COMPLETED: November 1, 1960

<u>FORMATION</u>	<u>FROM</u>	<u>TO</u>	<u>REMARKS</u>
Surface Clay & Sand	0	170	Ran 915.60' (29 Jts.) of 8-5/8" surface casing; set and cemented at 922.60' with 450 sacks of common cement, 2% gel and 2% C. C. Plug down @ 12:00 noon 10-18-1960.
Shale & Red Bed	170	710	
Shale & Shells	710	925	
Shale	925	1560	
Shale w/Lime streaks	1560	1810	
Lime & Shale	1810	3475	
Lime	3475	3700	
Shale & Lime	3700	3820	
Lime	3820	4278	
Lime, Shale & Chert	4278	4318	
Shale & Lime	4318	4354	
Shale	4354	4390	
Viola	4390	4405	
Viola Lime & Chert	4405	4413	
Lime	4413	4444	
Lime & Chert	4444	4480	
Lime & Chert	4480	4505	
Lime	4505	4511	
Sand & Shale	4511	4571	
Sand	4571	4575	

Total Depth 4575'

Ran 4574' (146 Jts.) of 5 1/2" casing; set and cemented at 4574' with 165 sacks of common cement. Plug down at 4:15 P. M. 11-1-1960.

STATE OF KANSAS)
 COUNTY OF BARTON) ss.

RECEIVED
 STATE CORPORATION COMMISSION
 MAR 02 1978
 CONSERVATION DIVISION
 Wichita, Kansas

I certify that this is a true and correct copy of the above log to the best of my knowledge.

STRATA DRILLING, INC.
 STRATA DRILLING, INC.

Jim B. McWilliams
 Jim B. McWilliams, Secy-Treas.

Subscribed and sworn to before me this 2nd day of November, 1960.

Elaine H. Taylor
 Elaine H. Taylor, Notary Public

Commission Expires:
 November 14, 1961