

STATE OF KANSAS
STATE CORPORATION COMMISSION

Form CP-4


Give All Information Completely
Make Required Affidavit
Mail or Deliver Report to:
Conservation Division
State Corporation Commission
212 No. Market
Wichita, Kansas

WELL PLUGGING RECORD

Pratt County, Sec. 19 Twp. 27 Rge. 12 (E) W(W)

Location as "NE/CNW/SW" or footage from lines NE NW NW
Lease Owner Clay Newell
Lease Name Justice "B" Well No. 1
Office Address Box "D" Stafford, Kansas
Character of Well (completed as Oil, Gas or Dry Hole) Oil
Date well completed _____ 19____
Application for plugging filed _____ 19____
Application for plugging approved _____ 19____
Plugging commenced _____ 9/27 19 71
Plugging completed _____ 9 40/30 19 71
Reason for abandonment of well or producing formation _____

NORTH

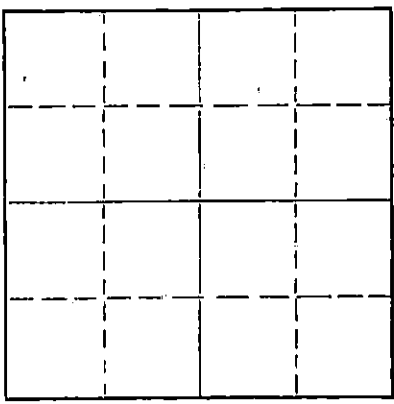

Locate well correctly on above Section Plat

If a producing well is abandoned, date of last production _____ 19____

Was permission obtained from the Conservation Division or its agents before plugging was commenced? Yes

Name of Conservation Agent who supervised plugging of this well Russell Beberstein

Producing formation Shinarump Depth to top _____ Bottom _____ Total Depth of Well 4360 Feet

Show depth and thickness of all water, oil and gas formations.

OIL, GAS OR WATER RECORDS

CASING RECORD

FORMATION	CONTENT	FROM	TO	SIZE	PUT IN	PULLED OUT
				8 5/8"	445'	0
				5 1/2"	4358'	2732'

Describe in detail the manner in which the well was plugged, indicating where the mud fluid was placed and the method or methods used in introducing it into the hole. If cement or other plugs were used, state the character of same and depth placed, from _____ feet to _____ feet for each plug set.

Filled with sand from 4360' to 4300'. Run 5 sacks of cement from 4300' to 4270'. Set plug at 270'. Rock to 260'. Run 4 yards of ready mix cement from 260' to base of cellar.

RECEIVED
STATE CORPORATION COMMISSION
OCT 12 1971
CONSERVATION DIVISION
Wichita, Kansas

(If additional description is necessary, use BACK of this sheet)

Name of Plugging Contractor Glenn & Smith Pipe Pulling Co.
Address Box 156 Ellinwood, Kansas 67526

STATE OF Kansas, COUNTY OF Stafford, ss.
Clay H. Newell (employee of owner) or (owner or operator) of the above-described

well, being first duly sworn on oath, says: That I have knowledge of the facts, statements, and matters herein contained and the log of the above-described well as filed and that the same are true and correct. So help me God.

(Signature) Clay Newell
Stafford Kansas (Address)

SUBSCRIBED AND SWORN TO before me this 11th day of October, 19 71

G. Titus Hawver
G. Titus Hawver
Notary Public.

Nov. 5, 1973



File

COOPERATIVE REFINERY ASSOCIATION

Great Bend, Kansas

DRILLING LOG

Justice "D" #1
Secs: 19-27-12
Loc: G-ME-MW-27
Pratt County, Kansas
Operator: Cooperative Refinery Ass'n.
Contractor: Schafer Drilling Company

Comm: February 4, 1953
Comp: February 26, 1953

Casing: 8 5/8" 445' w/ 300 wt
5 1/2" 500.69' w/ 200 wt.

0	115	Sand
115	255	Red Bed, Shale & Shells
255	445	Red Bed, Shells
445	670	Red Bed, Shells
670	685	Anhydrite
685	850	Red Beds & Shells
850	1110	Shale & Shells
1110	1350	Shale & Salt
1350	1415	Shale & Shells
1415	1730	Shale & Shells
1730	1860	Shale & Lime
1860	1970	Broken Lime
1970	2120	Lime & Shale
2120	2235	Lime
2235	2505	Shale & Lime
2505	2680	Shale
2680	3210	Shale & Lime
3210	3445	Lime
3445	3735	Lime & Shale
3735	4112	Lime
4112	4145	Lime & Chert
4145	4210	Lime & Chert
4210	4265	Lime, Chert & Shale
4265	4275	Lime & Chert
4275	4283	Lime, Shale & Chert
4283	4289	Shale & Sand
4289	4311	Sand
4311	4356	Sand - R.T.D.

RECEIVED
STATE CORPORATION COMMISSION
SEP 9 1971
CONSERVATION DIVISION
Wichita, Kansas

I certify that this is the true and correct copy of the above log, to the best of my knowledge.

L. M. Collins

Subscribed and sworn to before me this 24 day of March 1953.

Clyde E. Endicott
Notary Public

By commission Expires: 2-20-57