

STATE OF KANSAS  
STATE CORPORATION COMMISSION

Form CP-4


Give All Information Completely  
Make Required Affidavit  
Mail or Deliver Report to:  
Conservation Division  
State Corporation Commission  
212 No. Market  
Wichita, Kansas

WELL PLUGGING RECORD

Pratt County, Sec. 19 Twp. 27 Rge. 12 (E) W (W)

Location as "NE/CNW/SW" or footage from lines C SE 1/4 NW 1/4 NW 1/2  
Lease Owner Clay Newell  
Lease Name Justice Well No. 5  
Office Address Stafford, Ks.  
Character of Well (completed as Oil, Gas or Dry Hole)  
Date well completed 19\_\_  
Application for plugging filed 19\_\_  
Application for plugging approved 19\_\_  
Plugging commenced 4/29/70 19\_\_  
Plugging completed 5/4/70 19\_\_  
Reason for abandonment of well or producing formation

NORTH

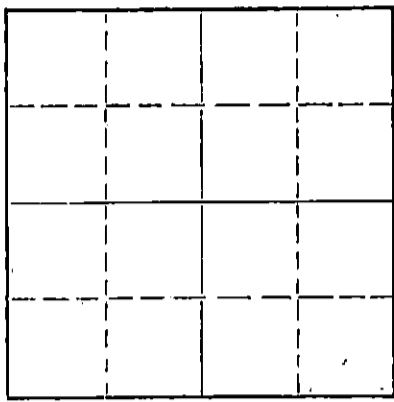

Locate well correctly on above Section Flat

If a producing well is abandoned, date of last production 19\_\_  
Was permission obtained from the Conservation Division or its agents before plugging was commenced? Yes

Name of Conservation Agent who supervised plugging of this well Russell Beberstein  
Producing formation Depth to top Bottom Total Depth of Well 4368 Feet  
Show depth and thickness of all water, oil and gas formations.

OIL, GAS OR WATER RECORDS

CASING RECORD

FORMATION	CONTENT	FROM	TO	SIZE	PUT IN	PULLED OUT

RECEIVED  
STATE CORPORATION COMMISSION  
MAY 11 1970  
CONSERVATION DIVISION  
Wichita, Kansas

Describe in detail the manner in which the well was plugged, indicating where the mud fluid was placed and the method or methods used in introducing it into the hole. If cement or other plugs were used, state the character of same and depth placed, from feet to feet for each plug set.  
Sand from 4368' to 4315'. Run 5 sacks of cement from 4315' to 4285'.  
Pumped 15 sacks of gel mud & 100 sacks of cement to base of cellar.

(If additional description is necessary, use BACK of this sheet)

Name of Plugging Contractor Glenn & Smith Pipe Pulling Co.  
Address Box 156 Ellinwood, Ks.


STATE OF Kansas COUNTY OF Stafford, ss.  
Clay Newell (employee of owner) or (owner or operator) of the above-described well, being first duly sworn on oath, says: That I have knowledge of the facts, statements, and matters herein contained and the log of the above-described well as filed and that the same are true and correct. So help me God.

(Signature) Clay Newell

(Address)

SUBSCRIBED AND SWORN TO before me this 8th day of May, 1970

My commission expires 5-10-72

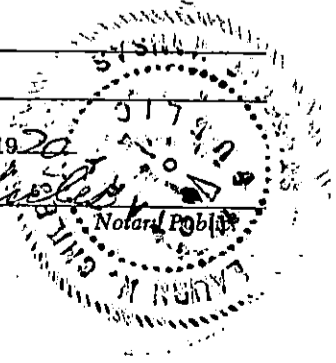

DRILLERS LOG

Justice "B" #5

Loc: C-SE/4-N4/4-W/4  
 Sec: 19-27S-12W  
 Pratt County, Kansas  
 Operator: Cooperative Refinery Ass'n.  
 Contractor: Company Rig #5

Elevation: 1892 R.B.  
 Casings: 8 5/8" @ 430' w/ 300 sx. posmix  
 5 1/2" @ 4367 R.B. w/ 125 sx. common  
 Comm: 3-7-56 Comp: 3-28-56  
 Total Depth: 4368 R.B.

From	To	Formation
0	125	Surface hole
125	430	Sandy, red bed, shells
430	1225	Shale and shells
1225	1560	Sand and shale
1560	1865	Shale and shells
1865	2075	Shale and lime
2075	2165	Lime
2165	2535	Lime and shale
2535	2685	Shale
2685	2800	Shale and shells
2800	2895	Shale and lime
2895	3010	Shale
3010	3805	Shale and lime
3805	3895	Lime
3895	3945	Lime and shale
3945	4040	Lime
4040	4080	Lime and shale
4080	4180	Lime
4180	4265	Lime and chert
4265	4368	Lime and shale
4368		R.T.D.

RECEIVED  
 STATE CORPORATION COMMISSION  
 APR 16 1970  
 CONSERVATION DIVISION  
 Wichita, Kansas

(STATE OF KANSAS )  
 (COUNTY OF BARTON)

I hereby certify that the above is a true and correct copy of the log on the Justice "B" #5 well, located C-SE/4-N4/4-W/4, of Section 19-27S-12W, Pratt County, Kansas.

*[Signature]*

Subscribed and sworn to before me this 4 day of April, 1956.

*[Signature]*

My commission expires: September 2, 1959