


STATE OF KANSAS  
STATE CORPORATION COMMISSION

Give All Information Completely  
Make Required Affidavit  
Mail or Deliver Report to:  
Conservation Division  
State Corporation Commission  
800 Bittling Building  
Wichita, Kansas

WELL PLUGGING RECORD

NORTH

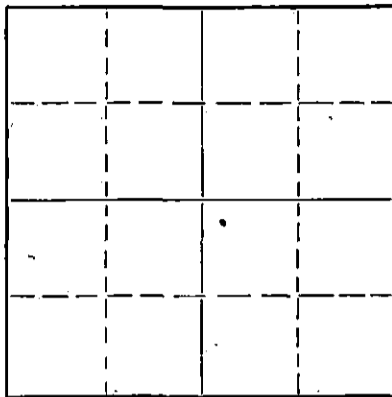

Locate well correctly on above  
Section Plat

Pratt County. Sec. 19 Twp. 27 Rge. 12 ~~NE~~ W (W)

Location as "NE/CNW/SW" or footage from lines NW NW SW

Lease Owner E. B. Stableford

Lease Name Helmke Well No. 1

Office Address 1003 Central Bldg, Wichita, Kansas

Character of Well (completed as Oil, Gas or Dry Hole) Dry Hole

Date well completed April 8 1953

Application for plugging filed April 8 1953

Application for plugging approved April 8 1953

Plugging commenced April 8 1953

Plugging completed April 8 1953

Reason for abandonment of well or producing formation Dry Hole

If a producing well is abandoned, date of last production None 19  

Was permission obtained from the Conservation Division or its agents before plugging was commenced? Yes

Name of Conservation Agent who supervised plugging of this well S. S. Greider

Producing formation None Depth to top    Bottom    Total Depth of Well 4410 Feet

Show depth and thickness of all water, oil and gas formations.

OIL, GAS OR WATER RECORDS

CASING RECORD

FORMATION	CONTENT	FROM	TO	SIZE	PUT IN	PULLED OUT
		0	250	8 5/8	3-22-53	Left in Hole

Describe in detail the manner in which the well was plugged, indicating where the mud fluid was placed and the method or methods used in introducing it into the hole. If cement or other plugs were used, state the character of same and depth placed, from 250 feet to 30 feet for each plug set.

Hole was pumped full of heavy mud and 1 plug was set at 250 feet, 20 sacks of cement were mixed and pumped through drill pipe to top of plug. One plug was set at 25 feet and 10 sacks of cement were hand mixed and pumped on top of plug. Surface pipe was then cut off four (4) feet under ground level.

RECEIVED  
STATE CORPORATION COMMISSION  
APR 21 1953 4-21-53  
CONSERVATION DIVISION  
Wichita, Kansas

(If additional description is necessary, use BACK of this sheet)

Name of Plugging Contractor Schafer Drilling Company  
Address Peoples Bank Building, Pratt, Kansas

STATE OF KANSAS, COUNTY OF PRATT, ss.

(employee of owner) or (owner or operator) of the above-described well, being first duly sworn on oath, says: That I have knowledge of the facts, statements, and matters herein contained and the log of the above-described well as filed and that the same are true and correct. So help me God.

(Signature) [Signature]  
Great Bend Kan  
(Address)

SUBSCRIBED AND SWORN TO before me this 20th day of April, 1953

My commission expires February 25, 1956  
Hilda Coulter  
Notary Public.

PLUGGING  
FILE SEC 19 T 27 R 12W  
BOOK PAGE 91 LINE 5

Drilling Log  
Helmke #1

0-120	Sand
120-663	Red Bed
663-685	Anhydrite
685-940	Red Bed and Shale
940-1700	Shale and shells
1700-1945	Lime and shale
1945-2115	Lime Broken
2115-2600	Lime and shale
2600-2655	Shale
2655-2830	Sticky shale
2830-2970	Shale
2970-3210	Shale and lime
3210-3520	Lime
3520-3730	Shale and lime
3730-4190	Lime
4190-4218	Lime and chert
4218-4302	Lime, shale and chert
4302-4359	Coring
4359-4375	Shale
4375-4396	Sandy shale and lime
4396-4410	Lime
4410	TOTAL DEPTH

-----C O P Y-----

I certify that the above drilling log was taken from the daily drilling reports for the Helmke #1, and is true and correct.

SCHAFFER DRILLING COMPANY

by James E. Selby  
Bookkeeper

STATE OF KANSAS, COUNTY OF PRATT, ss.

Subscribed and Sworn to before me this 25th day of Sept. 1953

Hilda Coulter  
Notary Public

My commission expires February 25, 1954

RECEIVED  
STATE CORPORATION COMMISSION

SEP 25 1953

CONSERVATION DIVISION  
Wichita, Kansas