


STATE OF KANSAS  
STATE CORPORATION COMMISSION  
200 Colorado Derby Bldg.  
Wichita, Kansas 67202

Form CP-4  
Rev. 12-15-80

WELL PLUGGING RECORD

Give All Information Completely  
Make Required Affidavit

COUNTY Pratt SEC. 19 TWP. 27S RGE. 12W E/W  
Location as in quarters or footage from lines:  
330' FSI 990' FEI NE/4

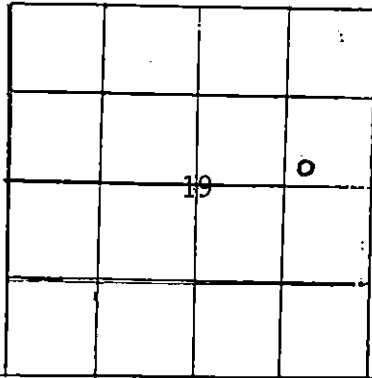

Locate Well  
correctly on above  
Section Pratt.

Lease Owner North American Royalties, Inc.  
Lease Name Davault Well No. 1  
Office Address 5101 North Classen, Suite 500, Oklahoma City, OK 73118  
Character of Well (Completed as Oil, Gas or Dry Hole): Dry Hole  
Date Well Completed September 2, 1982  
Application for plugging filed Plugging instructions received by phone  
no agent present for plugging operation.  
Plugging commenced September 2, 1982  
Plugging completed September 2, 1982  
Reason for abandonment of well or producing formation \_\_\_\_\_

No show of oil or gas  
Was permission obtained from the Conservation Division or it's  
Agent's before plugging was commenced? yes

Name of Conservation Agent who supervised plugging of this well Steve Durrant  
Producing formation None Depth to top \_\_\_\_\_ bottom T.D. 4540'

Show depth and thickness of all water, oil and gas formations.

OIL, GAS OR WATER RECORDS Casing Record

Formation	Content	From	To	Size	Put in	Pulled Out
Indian Cave	Water	2733	43			
Lansing - K.C.	Water	3758	4112			
Miss	Water	4216	4298			
Simpson Dolomite	Water	4420	36			
Simpson Sand	Water	4441	60			

Describe in detail the manner in which the well was plugged, indicating where the mud fluid was placed and the method or methods used in introducing it into the hold. If cement or other plugs were used, state the character of same and depth placed, from \_\_\_\_\_ feet to \_\_\_\_\_ feet for each plug set. The hole was filled with 9.5 pound per gallon mud and the well was plugged with a total of 120 sx 50/50 poz with 4% gel and 3% CaCl as follows:

- 50 sk plug at 660'
- 50 sk plug at 450'
- 10 sk plug at top of hole
- 10 sk plug in rat hole

(If additional description is necessary, use BACK of this sheet)

Name of Plugging Contractor Dowell

STATE OF Oklahoma COUNTY OF Oklahoma, ss.  
C. Mark Ready (employee of owner) or (~~owner/op/oper/prop~~) of the  
above-described well, being first duly sworn on oath, says: That I have knowledge of the  
facts, statements, and matters herein contained and the log of the above-described well as  
filed and that the same are true and correct. So help me God.

(Signature) C. Mark Ready  
5101 N. Classen Suite 500 OKC 73118  
(Address)

SUBSCRIBED AND SWORN TO before me this 16 day of September, 19 82

My Commission expires 9/10/84



RECEIVED  
Nancy D. Howard  
Notary Public.  
STATE CORPORATION COMMISSION  
'SEP 17 1982  
CONSERVATION DIVISION  
Wichita, Kansas