

STATE OF KANSAS
STATE CORPORATION COMMISSION


Form CP-4

Give All Information Completely
Make Required Affidavit
Mail or Deliver Report to:
Conservation Division
State Corporation Commission

WELL PLUGGING RECORD

P. O. Box 17027
Wichita, Kansas 67217
NORTH

Kiowa County. Sec. 14 Twp. 27S Rge. (E) 18 (W)
Location as "NE/CNW/SW" or footage from lines. C NW NE
Lease Owner Barnett Oil, Inc.
Lease Name KELLER Well No. #1
Office Address 411 First National Bank Bldg, Wichita, Ks.
Character of Well (completed as Oil, Gas or Dry Hole) Dry Hole
Date well completed July 28 19 74
Application for plugging filed (verbally) July 28 19 74
Application for plugging approved (verbally) July 28 19 74
Plugging commenced July 28 19 74
Plugging completed July 28 19 74
Reason for abandonment of well or producing formation _____

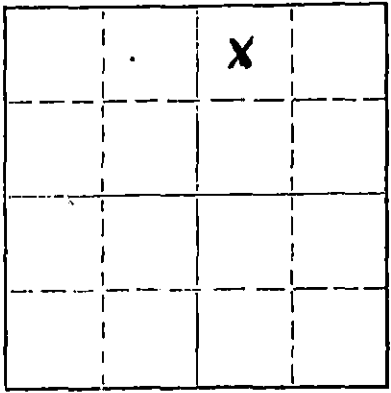

Locate well correctly on above
Section Flat

If a producing well is abandoned, date of last production _____ 19____
Was permission obtained from the Conservation Division or its agents before plugging was commenced? Yes (verbally)

Name of Conservation Agent who supervised plugging of this well G. R. Biberstein
Producing formation _____ Depth to top _____ Bottom _____ Total Depth of Well 4810 Feet
Show depth and thickness of all water, oil and gas formations.

OIL, GAS OR WATER RECORDS

CASING RECORD

FORMATION	CONTENT	FROM	TO	SIZE	PUT IN	PULLED OUT
				8 5/8"	317'	None

Describe in detail the manner in which the well was plugged, indicating where the mud fluid was placed and the method or methods used in introducing it into the hole. If cement or other plugs were used, state the character of same and depth placed, from _____ feet to _____ feet for each plug set.

1st Plug set at 500' with 40 Sacks Common Cement
2nd Plug set at 300' with 30 sacks Common Cement
3rd Plug set at 40' with 15 Sacks Common Cement
Plugged Rathole with 2 sacks Common Cement

RECEIVED
STATE CORPORATION COMMISSION
AUG 5 1974
CONSERVATION DIVISION
Wichita, Kansas

(If additional description is necessary, use BACK of this sheet)
Name of Plugging Contractor Abercrombie Drilling, Inc.
Address 801 Union Center, Wichita, Kansas 67202

STATE OF KANSAS, COUNTY OF SEDGWICK, ss.
Jerry A. Langrehr (employee of owner) or (owner or operator) of the above-described

well, being first duly sworn on oath, says: That I have knowledge of the facts, statements, and matters herein contained and the log of the above-described well as filed and that the same are true and correct. So help me God.

(Signature) Jerry A. Langrehr
801 Union Center, Wichita, Kansas 67202
(Address)

NANCY E. BLEDSOE
NOTARY PUBLIC
WICHITA, KANSAS
My commission expires _____
WICK CO.

Subscribed and sworn to before me this 30th day of July, 19 74

Nancy E. Bledsoe
Nancy E. Bledsoe Notary Public.

April 8, 1978

CONTRACTOR'S WELL LOG

OPERATOR:	Barnett Oil, Inc.
CONTRACTOR:	Abercrombie Drilling, Inc.
WELL NAME:	KELLER #1
LOCATION:	C NW NE Sec. 14-27S-18W Kiowa County, Kansas
GEOLOGIST:	Alfred Stude
SPUD DATE:	July 16, 1974
COMPLETION DATE:	July 28, 1974

RECEIVED
 STATE CORPORATION COMMISSION
 AUG 1 1974
 CONSERVATION DIVISION
 Wichita, Kansas

0	318	Sand
318	1575	Shale and Sand
1575	2090	Shale
2909	3000	Shale and Lime
3000	3107	Lime
3107	3407	Lime and Shale
3407	3705	Lime
3705	4071	Lime and Shale
4071	4642	Lime
4642	4743	Lime and Shale
4743	3810	Lime
	4810	Rotary Total Depth

Drilled 317' of 12 $\frac{1}{4}$ " hole. Set 8 5/8" surface casing @ 317'. Cemented with 300 Sacks Quick-Set Cement. Cement Circulated. Plug was down at 12:00 a.m., July 16, 1974.

D & A: Set 1st Plug at 500' with 40 sacks common, 2nd plug set at 300' with 30 sacks common, 3rd plug set at 40' with 15 sacks common and plugged rathole with 2 sacks common. Plug was down at 4:30 p.m., July 28, 1974. State Plugger: G. R. Biberstein

<u>LOG TOPS:</u>	<u>ELEVATION:</u>
Lansing 4145 (-1975)	2170 K.B.
Mississippian 4731 (-2561)	2168 D.F.
	2162 G.L.

STATE OF KANSAS)
) SS
 COUNTY OF SEDGWICK)

Jerry A. Langrehr, Vice President of Abercrombie Drilling, Inc., does hereby state that the above and foregoing is a true and correct copy of the log of the KELLER #1, C NW NE Section 14-27S-18W, Kiowa County, Kansas.

ABERCROMBIE DRILLING, INC.

By: Jerry A. Langrehr
 Jerry A. Langrehr
 Vice President

Subscribed and sworn to before me, a Notary Public, in and for the aforesaid county and state as of this 30th day of July.

Nancy E. Bledsoe
 Nancy E. Bledsoe - Notary
 Public

