

STATE OF KANSAS
STATE CORPORATION COMMISSION

WELL PLUGGING RECORD

Give All Information Completely
Make Required Affidavit
Mail or Deliver Report to
Conservation Division
State Corporation Comm.
245 North Water
Wichita, KS 67202.

Kiowa County, County. Sec. 33 Twp. 27S Rge. 17 W
Location as "NE/CNW/SW" or footage from lines
C-NE-NE


Lease Owner Stelbar Oil Corporation, Inc.
Lease Name Heston Well No. 1
Office Address 450 Fourth Financial Center, Wichita, Ks.
Character of Well (Completed as Oil, Gas or Dry Hole)
Gas Well

Date Well completed 4-10 through 4-19, 1982
Application for plugging filed July 22, 1982
Application for plugging approved August, 1982
Plugging commenced Sept 29, 1982
Plugging completed Oct. 1, 1982
Reason for abandonment of well or producing formation
Dry Hole

If a producing well is abandoned, date of last product:
None

Was permission obtained from the Conservation Division
its agents before plugging was commenced? Yes

Name of Conservation Agent who supervised plugging of this well Steve Durant
Producing formation Mississippian Depth to top 4668' Bottom 4779' Total Depth of Well 4780'
Show depth and thickness of all water, oil and gas formations.

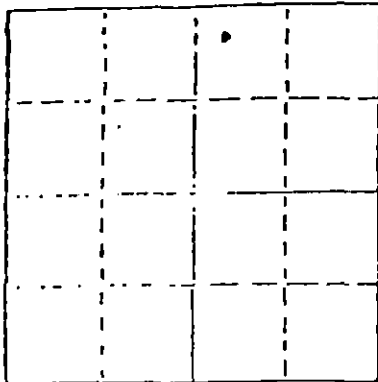

Locate well correctly on above
Section Plat

OIL, GAS OR WATER RECORDS

CASING RECORD

FORMATION	CONTENT	FROM	TO	SIZE	PUT IN	PULLED OUT
Surface Pipe		0'	385'	8 5/8"	4/11/82	
Casing Pipe		0'	4779'	4 1/2"	4/19/82	9/30/82

Describe in detail the manner in which the well was plugged, indicating where the plug was placed and the method or methods used in introducing it into the hole. If cement or plugs were used, state the character of same and depth placed, from 4779' feet to 4714' feet for each plug set. Sand fillup with 4 sacks of common cement on top.
Ran a free point on the 4 1/2" pipe and shot off at 2596'. Pulled free and laid casing down. Rigged up Halco and pumped 3 sk hulls, 10 sx gel, 50 sx common cement, 10 sx gel, 1 sx hulls, released plug and pumped 100 sx of 50/50 poz/mix. Left 350 # on surface pipe. Plug down @ 11:25 AM.

(If additional description is necessary, use BACK of this sheet)

Name of Plugging Contractor Pratt Well Service, Inc.

STATE OF Kansas COUNTY OF Pratt, ss.
Kenneth C. Gates (employee of owner) or (owner or agent of the above-described well, being first duly sworn on oath, says: That I have knowledge of the facts, statements, and matters herein contained and the log of the above-described well as filed and that the same are true and correct. So help me God.

(Signature) Kenneth C. Gates
Box 847 Pratt, KS 67124
(Address)

SUBSCRIBED AND SWORN TO before me this 30th day of November, 1982

Charlene M. Dudley
Notary Public.
RECEIVED
My commission expires 9/10/86

My commission expires 9/10/86

STATE CORPORATION COMMISSION

DEC 1 1982

CONSERVATION DIVISION
Wichita, Kansas

