


STATE OF KANSAS
STATE CORPORATION COMMISSION

WELL PLUGGING RECORD

Give All Information Completely
Make Required Affidavit
Mail or Deliver Report to
Conservation Division
State Corporation Comm.
245 North Water
Wichita, KS 67202

Kiowa County. Sec. 23 Twp. 25 Rge. 17 ~~XX~~
Location as "NE/CNW $\frac{1}{4}$ SW $\frac{1}{4}$ " or footage from lines _____
C NW SE

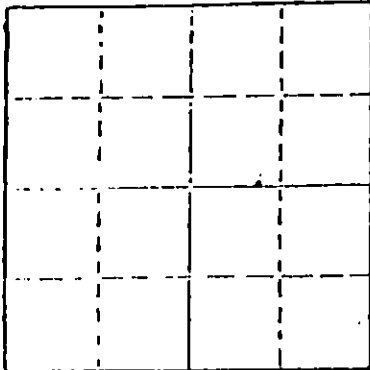

Locate well correctly on above
Section Plot

Lease Owner White & Ellis Drlg. Inc.
Lease Name Erwin Well No. 1
Office Address 7701 E. Kellogg; Suite 290; Wichita, Ks.
Character of Well (Completed as Oil, Gas or Dry Hole) _____

Dry Hole
Date Well completed 12/1/79
Application for plugging filed 12/1/79
Application for plugging approved 12/1/79
Plugging commenced 12/1/79
Plugging completed 12/1/79
Reason for abandonment of well or producing formation _____

Dry HOLE
If a producing well is abandoned, date of last production: _____

Was permission obtained from the Conservation Division or its agents before plugging was commenced? Yes

Name of Conservation Agent who supervised plugging of this well Wm. T. Owen
Producing formation _____ Depth to top _____ Bottom _____ Total Depth of Well _____
Show depth and thickness of all water, oil and gas formations.

OIL, GAS OR WATER RECORDS

CASING RECORD

FORMATION	CONTENT	FROM	TO	SIZE	PUT IN	PULLED OUT
				8 5/8"	364'	

Describe in detail the manner in which the well was plugged, indicating where the mud fluid was placed and the method or methods used in introducing it into the hold. If cement or other plugs were used, state the character of same and depth placed, from _____ feet to _____ feet for each plug set.

12/1/79 Mud to 390', plug, plugged with 50 sx. cement.
12/1/79 Mud to 40', plug, plugged with 10 sx. cement.
12/1/79 Plugged rathole with 5 sx. cement.

(If additional description is necessary, use BACK of this sheet).

Name of Plugging Contractor White & Ellis Drilling, Inc.
Box 448; El Dorado, Ks. 67042

STATE OF Kansas COUNTY OF Butler, ss.
Ernest Sifford (employee of owner) or (owner or operator)

of the above-described well, being first duly sworn on oath, says: That I have knowledge of the facts, statements, and matters herein contained and the log of the above-described well as filed and that the same are true and correct. So help me God.

(Signature) Ernest Sifford
El Dorado
(Address)

SUBSCRIBED AND SWORN TO before me this 12 day of December, 19 79

My commission expires _____



L. B. Auer

RECEIVED
STATE CORPORATION COMMISSION

DEC 21 1979

CONSERVATION DIVISION
Wichita, Kansas

DRILLERS LOG

OPERATOR: White & Ellis Drlg, Inc.; Suite 290; 7701 E. Kellogg; Wichita, Ks.
 CONTRACTOR: **White & Ellis Drilling, Inc., Box 448, El Dorado, Kansas 67042** 67207

Lease Name Erwin Well No. 1

Sec. 23 T. 27 R. 17W Spot C NW SE

County Kiowa State Kansas Elevation _____

Casing Record:

Surface: 8 5/8" @ 364' with 300 Sxs.

Production: _____ @ _____ with _____ Sxs.

Type Well: D & A Total Depth 4670' KB

Drilling Commenced: 11/18/79 Drilling Completed 12/1/79

Formation	From	To	Tops
Cellar	0	7	
Shale	7	2020	
Shale, Lime	2020	2200	
Lime	2200	2398	
Shale	2398	2420	
Lime, Shale	2420	2625	
Lime	2625	2673	
Lime, Shale	2673	3505	
Lime	3505	3603	
Lime, Shale	3603	4018	
Lime	4018	4265	
Lime, Shale	4265	4670	

RECEIVED
 STATE CORPORATION COMMISSION
 DEC 21 1979
 CONSERVATION DIVISION
 Wichita, Kansas

COMPLETION RECORD

Liner Record: Size _____ From _____ To _____

Cementing Record: _____ Sacks _____

Perforating Record:

Formation	Perforated Interval	Number Shots

Initial Production: _____

Electric Log Type and Depths Covered
