

CARD MUST BE TYPED

State of Kansas

CARD MUST BE SIGNED

NOTICE OF INTENTION TO DRILL

(see rules on reverse side)

Expected Spud Date..... May 4, 1987
month day year

API Number 15- 151-21,571-~~A~~ ⁻⁰⁰⁻⁰¹
Approx. _____ East
SW. SW. SW Sec. 24. Twp. 29. S. Rg. 13. West
430 _____ Ft. from South Line of Section
4950 _____ Ft. from East Line of Section

OPERATOR: License # 9854
Name: MarMac Petroleum Company
Address: 1026 Union Center Building
City/State/Zip: Wichita, Kansas 67202
Contact Person: Doug McGinness, II
Phone: (316) 269-3424

(Note: Locate well on Section Plat on reverse side)
Nearest lease or unit boundary line 330 feet
County: Pratt
Lease Name: Flora Well # 1-24

CONTRACTOR: License # 5381
Name: Big Springs Drilling, Inc.
City/State: Wichita, Kansas

Ground surface elevation 1887 feet MSL
Domestic well within 330 feet: _____ yes no
Municipal well within one mile: _____ yes no

Well Drilled For: Well Class: Type Equipment:
 Oil _____ Storage _____ Infield Mud Rotary
_____ Gas _____ Inj Pool Ext. _____ Air Rotary
 OWWO _____ Expl _____ Wildcat _____ Cable

Depth to bottom of fresh water 150'
Depth to bottom of usable water 250'
Surface pipe by Alternate: _____ 1 2 _____
Surface pipe placed on base 429' was set
Conductor pipe required None
Projected Total Depth 4715 feet
Formation: Arbuckle

If OWWO: old well info as follows:
Operator: White & Ellis
Well Name: #1 Flora
Comp Date: 02/22/85 Old Total Depth: 4715'

I certify that well will comply with K.S.A. 55-101, et seq., plus eventually plugging hole to KCC specifications
Date: 04/28/87 Signature of Operator or Agent: [Signature] Title: Secretary-Treasurer

For KCC Use:
Conductor Pipe Required feet; Minimum Surface Pipe Required 429 feet per Alt.
This Authorization Expires: 10-29-87 Approved By: 4-29-87 [Signature]

Must be filed with the K.C.C. five (5) days prior to commencing well
This card void if drilling not started within six (6) months of date received by K.C.C.


RECEIVED
STATE CORPORATION COMMISSION

Important procedures to follow:

A Regular Section of Land
1 Mile = 5,280 Ft.

APR 29 1987
04-29-87
CONSERVATION DIVISION
Wichita, Kansas

1. Notify District office before setting surface casing.
2. Set surface casing by circulating cement to the top.
3. File completion forms ACO-1 with K.C.C. within 120 days of well spud date, following instructions on ACO-1, side 1, and including copies of wireline logs.
4. Notify District office 48 hours prior to old well workover or re-entry.
5. Prior to filing Intent, prepare a proposed plugging plan in case well is D & A, then obtain approval of plan when calling district office prior to setting surface pipe.
6. Submit plugging report (CP-4) to K.C.C. after plugging is completed.
7. Obtain an approved injection docket number before disposing of salt water.
8. Notify K.C.C. within 10 days when injection commences or terminates.
9. If an alternate 2 completion, cement in the production pipe from below any usable water to surface within 120 days of spud date.

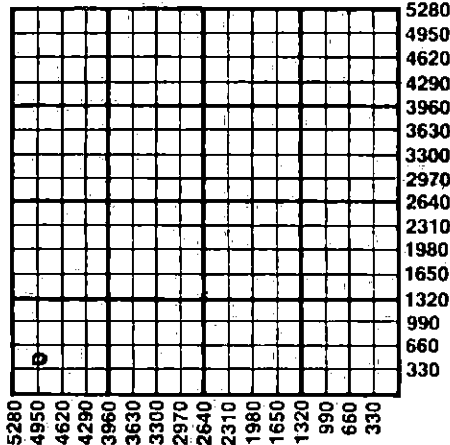

State Corporation Commission of Kansas
Conservation Division
200 Colorado Derby Building
Wichita, Kansas 67202-1212
(316) 263-3238