


STATE OF KANSAS
STATE CORPORATION COMMISSION

WELL PLUGGING RECORD

Give All Information Completely
Make Required Affidavit
Mail or Deliver Report to:
Conservation Division
State Corporation Commission
212 North Market, Insurance Bldg.
Wichita, Kansas

Kingman County, Sec. 14 Twp. 27 Rge. 10 (E) W(W)

Location as "NE/CNW%SW%" or footage from lines. C SE NW
Lease Owner Lawrence Supply Co., Inc.
Lease Name McMichael #3 Well No.
Office Address Great Bend, Kansas
Character of Well (completed as Oil, Gas or Dry Hole)
Date well completed 19
Application for plugging filed 19
Application for plugging approved 19
Plugging commenced 12-30-58 19
Plugging completed 1-6-59 19
Reason for abandonment of well or producing formation

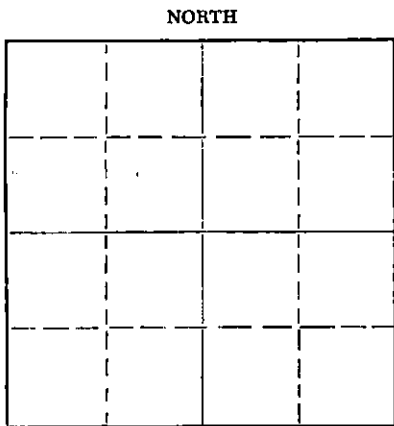

Locate well correctly on above Section Plat

If a producing well is abandoned, date of last production 19
Was permission obtained from the Conservation Division or its agents before plugging was commenced? yes

Name of Conservation Agent who supervised plugging of this well Fred Hample
Producing formation Depth to top Bottom Total Depth of Well 4290 Feet
Show depth and thickness of all water, oil and gas formations.

OIL, GAS OR WATER RECORDS

CASING RECORD

FORMATION	CONTENT	FROM	TO	SIZE	PUT IN	PULLED OUT
				8-5/8"	210'	none
				5-12/16"	4288'	3617'

Describe in detail the manner in which the well was plugged, indicating where the mud fluid was placed and the method or methods used in introducing it into the hole. If cement or other plugs were used, state the character of same and depth placed, from feet to feet for each plug set.

Checked the hole to 4290' and found it open. Filled w/sand to 4275' and dumped 5 sacks of cement with bailer. Pulled 65 jts of 5 1/2" casing and circulated pipe with 20 sacks of gel mud. Pulled rest of pipe, 51 jts, cleared hole and checked fluid to 60'. Bailed fluid to 260', set rock bridge to 250' and dumped 20 sacks of cement. Mudded the hole to 40', set rock bridge to 30' and ran 10 sacks of cement to base of cellar.

PLUGGING COMPLETED

(If additional description is necessary, use BACK of this sheet)

Name of Plugging Contractor West Supply Co., Inc.
Address Chase, Kansas

STATE OF KANSAS, COUNTY OF RICE, ss.
I, Noel J. Knight (employee of owner) or (owner) of the above-described well, being first duly sworn on oath, says: That I have knowledge of the facts, statements, and matters herein contained and the log of the above-described well as filed and that the same are true and correct. So help me God.

(Signature) [Signature] Chase, Kansas (Address)

SUBSCRIBED AND SWORN TO before me this 16th day of January, 1959

9-27-62

[Signature] Notary Public.

My commission expires

RECEIVED STATE CORPORATION COMMISSION

PLUGGING FILE SEC 14 T. 27 R. 10W BOOK PAGE 6 LINE 39

JAN 17 1959 CONSERVATION DIVISION Wichita, Kansas

WELL LOG BUREAU--KANSAS GEOLOGICAL SOCIETY
508 East Murdock, Wichita, Kansas


12A

Company- BENNETT & ROBERTS DRG., INC.
Farm- McMichael No. 3

SEC. 14 T. 27 R. 10W
C SE NW

Total Depth. 4290'
Comm. 11-30-55 Comp. 12-19-55
Shot or Treated.
Contractor.
Issued. 3-3-56

County Kingman
KANSAS

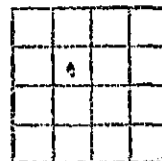

CASING:
8 5/8" 210' cem w/250 sx
5 1/2" 4288' cem w/100 sx

Elevation. 1754' DF

Production. 40 BOPD

Figures indicate Bottom of Formations.

sand and gravel	180
red bed & shells	500
red bed & shale	690
anhydrite	720
shale & shells	1395
lime & shale	1442
shale & shells	1500
lime & shale	1990
shale & lime	3360
lime	3480
lime & shale	3555
lime	4018
lime & chert	4065
lime & shale	4288 1/2 RTD
lime & shale	4290 CTD
Total Depth	

Tops: RB
Cimmerron Anhydrite 690
Mississippian Chert 4021
Kinderhook Shale 4084
Kinderhook Dolomite 4218
Viola 4287

no electric log run
no DST's.

RECEIVED
STATE CORPORATION COMMISSION
DEC 31 1958
CONSERVATION DIVISION
Wichita, Kansas

PLUGGING
FILE SEC 14 T. 27 R. 10W
BOOK PAGE 6 LINE 39