


STATE OF KANSAS
STATE CORPORATION COMMISSION

Give All Information Completely
Make Report Affidavit
Mail or Deliver Report to:
Conservation Division
State Corporation Commission
212 North Market, Insurance Bldg.
Wichita, Kansas

WELL PLUGGING RECORD

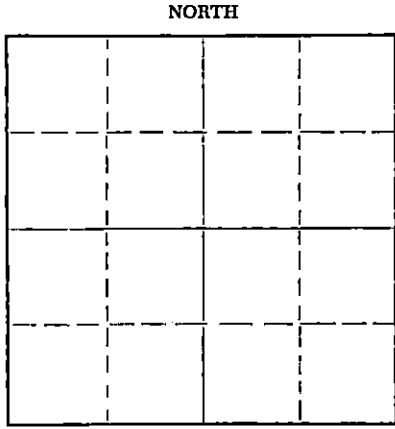

Kingman County. Sec. 14 Twp. 27 Rge. 10 (E) XX(W)
Location as "NE/CNW/SW" or footage from lines CE 1/2 SW SE
Lease Owner Morganstern & Spector
Lease Name Bick Well No. 5
Office Address Russell, Kansas
Character of Well (completed as Oil, Gas or Dry Hole) oil
Date well completed 9-18-51 19
Application for plugging filed Nov. 10, 1959 19
Application for plugging approved Nov. 12, 1959 19
Plugging commenced 12/10/59 19
Plugging completed 12/14/59 19
Reason for abandonment of well or producing formation failure to produce profitably
If a producing well is abandoned, date of last production _____ 19
Was permission obtained from the Conservation Division or its agents before plugging was commenced? Yes

Name of Conservation Agent who supervised plugging of this well Fred W. Hampel
Producing formation Viola Depth to top 4246 Bottom 4247 Total Depth of Well 4248 Feet
Show depth and thickness of all water, oil and gas formations.

OIL, GAS OR WATER RECORDS

CASING RECORD

FORMATION	CONTENT	FROM	TO	SIZE	PUT IN	PULLED OUT
				9 5/8" OD	2441	none
				5 1/2" OD	4247	3021.23

Describe in detail the manner in which the well was plugged, indicating where the mud fluid was placed and the method or methods used in introducing it into the hole. If cement or other plugs were used, state the character of same and depth placed, from _____ feet to _____ feet for each plug set.

Plugged back to 4250 ft. dumped 5 sacks cement. Set fresh water plug 450 ft. Set 10 ft. rock bridge. Dumped 20 sacks cement. Mudded hole to 35 ft. set rock bridge dumped 10 sacks cement.

RECEIVED
STATE CORPORATION COMMISSION

JAN 19 1960

CONSERVATION DIVISION

Wichita, Kansas

Name of Plugging Contractor E & L Casing Pulling Co.
Address 1416 Coolidge, Great Bend, Kansas

STATE OF Kansas COUNTY OF Russell, ss.
Morgenstern & Spector, Inc. (employee of owner) or (owner or operator) of the above-described well, being first duly sworn on oath, says: That I have knowledge of the facts, statements, and matters herein contained and the log of the above-described well as filed and that the same are true and correct. So help me God.

(Signature) Arthur Morgenstern
Box 661 - Russell, Kas
(Address)

SUBSCRIBED AND SWORN TO before me this 19 day of January 1960
J. E. Siegfried
Notary Public.

My commission expires 3-15-63



WELL LOG BUREAU—KANSAS GEOLOGICAL SOCIETY
508 East Murdock, Wichita, Kansas


COPY

Company- LION OIL COMPANY
Farm- Hick No. 5

SEC. 14 T. 27 R. 10W
C2 SW SE

Total Depth. 4248
Comm. 9-7-51 Comp. 9-18-51
Shot or Treated. Acid 500
Contractor. R. W. Rine Dglg Co.
Issued. 1-12-52

County Kingman
KANSAS

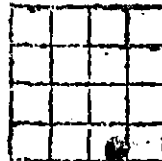

CASINO:

9 5/8" 244' cem w/250 sx.
5 1/2" 4247' cem w/200 sx.

Elevation. 1713 DF
Phys. Pot. Pump
Production. 219 bopd / no wtr.

Figures Indicate Bottom of Formations.

surface, clay, sand 100
red bed, shale 280
red bed 450
red bed, shals, salt 1215
shale 1415
lime 1925
shale 2645
lime, shale 3745
lime 3947
lime, shale 3987
lime Miss. 4034
shale, lime 4248
Total Depth

Tops:
Brown Lins 3462
Lansing 3470
Miss. 3987
Viola 4246

RECEIVED
STATE CORPORATION COMMISSION
JAN 7 1960
CONSERVATION DIVISION
Wichita, Kansas