


STATE OF KANSAS
STATE CORPORATION COMMISSION

WELL PLUGGING RECORD

Give All Information Completely
Make Required Affidavit
Mail or Deliver Report to:
Conservation Division
State Corporation Commission
212 North Market, Insurance Bldg.
Wichita, Kansas

Kingman County, Sec. 14 Twp. 27 Rge. 10 (E) (W)

Location as "NE/CNW/KSWK" or footage from lines NE SE SE
Lease Owner Morganstern & Spector
Lease Name Bick Well No. 2
Office Address Russell, Kansas
Character of Well (completed as Oil, Gas or Dry Hole) oil
Date well completed 8-2-51 19__
Application for plugging filed Nov. 10, 1959 19__
Application for plugging approved Nov. 12, 1959 19__
Plugging commenced 12/18/59 19__
Plugging completed 12/21/59 19__
Reason for abandonment of well or producing formation failure to produce profitably
If a producing well is abandoned, date of last production 19__
Was permission obtained from the Conservation Division or its agents before plugging was commenced? Yes

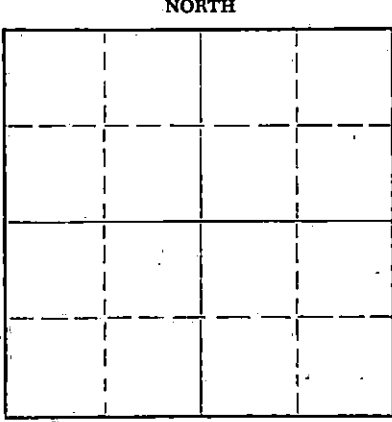

Locate well correctly on above Section Plat

Name of Conservation Agent who supervised plugging of this well Fred W. Hampel
Producing formation Viola Depth to top 4277 Bottom 4278 Total Depth of Well 4280 Feet
Show depth and thickness of all water, oil and gas formations.

OIL, GAS OR WATER RECORDS

CASING RECORD

FORMATION	CONTENT	FROM	TO	SIZE	PUT IN	PULLED OUT
				5 1/2" OD	4278'	3194.80'
				8 5/8" OD	307'	none

Describe in detail the manner in which the well was plugged, indicating where the mud fluid was placed and the method or methods used in introducing it into the hole. If cement or other plugs were used, state the character of same and depth placed, from _____ feet to _____ feet for each plug set.

Plugged back to 3183 ft. dumped 5 sacks cement. Set fresh water plug at 450 ft. Set 10 ft. rock bridge. Dumped 20 sacks cement. Mudded hole to 35 ft. set rock bridge dumped 10 sacks cement.

RECEIVED
STATE CORPORATION COMMISSION
1-19-60
JAN 19 1960

(If additional description is necessary, use BACK of this sheet)
Name of Plugging Contractor E & L Casings Pulling Co.
Address 1416 Coolidge, Great Bend, Kansas

CONSERVATION DIVISION
Wichita, Kansas

STATE OF Kansas, COUNTY OF Russell, ss.
Morganstern & Spector, Inc. (employee of owner) or (owner or operator) of the above-described well, being first duly sworn on oath, says: That I have knowledge of the facts, statements, and matters herein contained and the log of the above-described well as filed and that the same are true and correct. So help me God.

(Signature) Arthur Morganstern
Russell
(Address)

SUBSCRIBED AND SWORN to before me this 24th day of December, 19 59

My commission expires July 18, 1961

Jessie Lee Dunn
Jessie Lee Dunn
Notary Public.


WELL LOG BUREAU—KANSAS GEOLOGICAL SOCIETY
508 East Murdock, Wichita, Kansas

Company- LION OIL CO.
Farm- Bick No. 2

SEC. 14 T. 27 R. 10W
NE SE SE

Total Depth. 4280
Comm. 7-21-51 Comp. 8-2-51
Shot or Treated. Acid 1000
Contractor. H. W. Rine Drlg Co.
Issued. 9-29-51

County Kingman
KANSAS

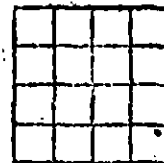

CASING:
8 5/8" 307' cem w/250 sx.
5 1/2" 4278' cem w/200sx.

Elevation. 1714

Production. BHB Potential 2358
BOPD

Figures Indicate Bottom of Formations.

sand	80
red bed	220
shale	1210
shale, shells, salt	1435
lime	1730
lime sandy	1925
lime, shale	2990
lime	3990
lime, chert	4060
chert, shale	4085
shale	4274
lime	4280
Total Depth	

Tops:	
Lansing	3504
Miss.	4026
Viola	4277

RECEIVED
STATE OF KANSAS COMMISSION

JAN 7 1960

CONSERVATION DIVISION
Wichita, Kansas