

OCT 12 1978


STATE OF KANSAS
STATE CORPORATION COMMISSION

WELL PLUGGING RECORD

Give All Information Completely
Make Required Affidavit
Mail or Deliver Report to
Conservation Division
State Corporation Comm.
245 North Water
Wichita, KS 67202

Kingman County, Sec. 22 Twp. 27S Rge. 10 E/W
Location as "NE/CNW $\frac{1}{4}$ SW $\frac{1}{4}$ " or footage from lines
SE NW SE

Lease Owner Rupe Oil Co., Inc.
Lease Name Gibbens "A" Well No. 1
Office Address P. O. Box 2273, Wichita, KS 67201
Character of Well (Completed as Oil, Gas or Dry Hole)
dry hole

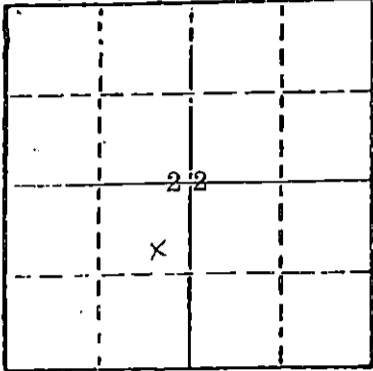

Locate well correctly on above
Section Plat

Date Well completed October 2, 1978 19
Application for plugging filed October 2, 1978 19
Application for plugging approved October 2, 1978 19
Plugging commenced October 2, 1978 19
Plugging completed October 2, 1978 19
Reason for abandonment of well or producing formation
dry

If a producing well is abandoned, date of last production
19

Was permission obtained from the Conservation Division or
its agents before plugging was commenced? yes

Name of Conservation Agent who supervised plugging of this well Wm. T. Owen
Producing formation Depth to top Bottom Total Depth of Well 2400
Show depth and thickness of all water, oil and gas formations.

OIL, GAS OR WATER RECORDS

CASING RECORD

FORMATION	CONTENT	FROM	TO	SIZE	PUT IN	PULLED OUT

Describe in detail the manner in which the well was plugged, indicating where the mud fluid was placed and the method or methods used in introducing it into the hold. If cement or other plugs were used, state the character of same and depth placed, from _____ feet to _____ feet for each plug set.

RECEIVED
STATE CORPORATION COMMISSION

First Plug set at 240' with 40 sacks
Second plug set at 40' with 12 sacks
five sack in rat hole

OCT 13 1978 10-13-78

CONSERVATION DIVISION
Wichita, Kansas

(If additional description is necessary, use BACK of this sheet)

Name of Plugging Contractor Union Drilling Co., Inc.

STATE OF KANSAS COUNTY OF SEDGWICK, ss.

R. D. Messinger (employee of owner) or (owner or operator)
of the above-described well, being first duly sworn on oath, says: That I have knowledge of the facts, statements, and matters herein contained and the log of the above-described well as filed and that the same are true and correct. So help me God,

(Signature) R. D. Messinger
505 Union Center, Wichita, KS 67202
(Address)

SUBSCRIBED AND SWORN TO before me this 3rd day of October, 1978

Cynthia L. Romey
Cynthia L. Romey Notary Public.

My Commission expires 6-2-82



CONTRACTOR'S WELL LOG

OPERATOR:
CONTRACTOR:
WELL NAME:
LOCATION:

Rupe Oil Co., Inc.
Union Drilling Co., Inc.
Gibbens "A" #1
SE NW SE Section 22-27S-10W
Kingman County, Kansas
September 26, 1978
October 2, 1978

COMMENCED:
COMPLETED:

0	1641	Shale	Set 8 5/8" @ 243' w/260 sacks
1641	1754	Shale and lime	
1754	1916	Lime and shale	
1916	1959	Shale	
1959	2153	Shale and lime	
2153	2400	Lime and shale	
	2400	T. D.	

We certify that the above and foregoing is a true and correct copy of the log on the Gibbens "A", SE NW SE Section 22-27S-10W, Kingman County, Kansas.

UNION DRILLING CO., INC.

R. D. Messinger
R. D. Messinger


STATE OF KANSAS)
) SS
COUNTY OF SEDGWICK)

Subscribed and sworn to before me, a Notary Public, in and for the aforesaid County and State as of this 4th day of October, 1978

My appointment expires:

6-2-82

Cynthia L. Romey
Cynthia L. Romey - Notary Public

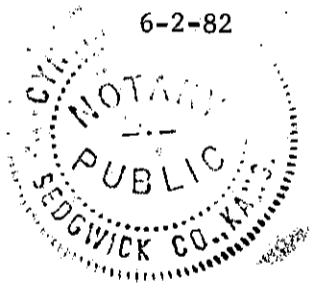

RECEIVED
STATE CORPORATION COMMISSION
OCT 13 1978
CONSERVATION DIVISION
Wichita, Kansas