


STATE OF KANSAS
CORPORATION COMMISSION

WELL PLUGGING RECORD

Give All Information Completely
Make Required Affidavit
Mail or Deliver Report to:
Conservation Division
State Corporation Commission
211 No. Broadway
Wichita, Kansas

Kingman County. Sec. 21 Twp. 27 Rge. 10W (E) (W)
Location as "NE/CNW/SW" or footage from lines NE NE NE
Lease Owner Bennett & Roberts Drilling Co.
Lease Name McNamee "A" Well No. 1
Office Address Russell, Ks.
Character of Well (completed as Oil, Gas or Dry Hole) Dry Hole
Date well completed 7/19 19 56
Application for plugging filed 7/19 verbally 19 56
Application for plugging approved 7/19 verbally 19 56
Plugging commenced 7/20 19 56
Plugging completed 7/20 19 56
Reason for abandonment of well or producing formation Dry Hole

NORTH

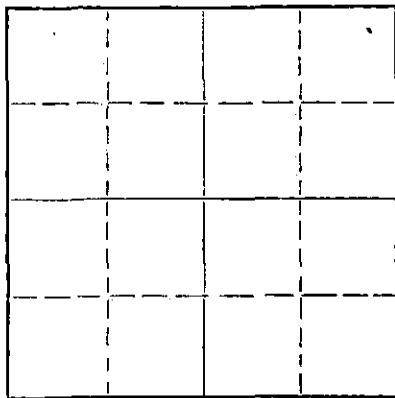

Locate well correctly on above
Section Plat

If a producing well is abandoned, date of last production 19
Was permission obtained from the Conservation Division or its agents before plugging was commenced? Yes

Name of Conservation Agent who supervised plugging of this well J. E. Brinegar
Producing formation Depth to top Bottom Total Depth of Well 4533 Feet
Show depth and thickness of all water, oil and gas formations.

OIL, GAS OR WATER RECORDS

CASING RECORD

FORMATION	CONTENT	FROM	TO	SIZE	PUT IN	PULLED OUT
				8 5/8"	230'	None

Describe in detail the manner in which the well was plugged, indicating where the mud fluid was placed and the method or methods used in introducing it into the hole. If cement or other plugs were used, state the character of same and depth placed, from feet to feet for each plug set.

Fill hole to 225', 1/4 sx hulls, 1st plug, 20 sx cement, ^{mud} ~~fluid~~ to 35', 1/4 sx hulls, 2nd plug, 10 sx cement to bottom of cellar.

(If additional description is necessary, use BACK of this sheet)

Name of Plugging Contractor
Address

STATE OF KANSAS, COUNTY OF RUSSELL, ss.
Harold Wurst (employee of owner) or (owner/operator) of the above-described well, being first duly sworn on oath, says: That I have knowledge of the facts, statements, and matters herein contained and the log of the above-described well as filed and that the same are true and correct. So help me God.

(Signature) Harold Wurst
Russell, Kansas (Address)

SUBSCRIBED AND SWORN TO before me this 24th day of July, 19 56

My commission expires 6/17/58

Notary Public.

PLUGGING
FILE SEC. 21 T. 27 R. 10W
BOOK PAGE 82 LINE 33

RECEIVED
STATE CORPORATION COMMISSION
JUL 25 1956 7-25-56
CONSERVATION DIVISION
Wichita, Kansas

Bennett & Roberts Drilling Co.
McNamee "A" #1

NE NE NE 21-27-10W
Kingman Co., Kans.

R.T.D. 4533

Contractor: Bennett & Roberts Drilling, Inc.

Commenced 7/2/56
Completed 7/20/56

Casing Record
8 5/8" Set @ 230' w/250' sx. cmt.

T o p s	
Cimarron Anhydrite	690
Lansing	3522
Kansas City	3725
Basal Kansas City	3922
Basal Pennsylvanian Sandstone	4032
Mississippian Chert	4039
Kinderhook Shale	4123
Viola	4320
Simpson Shale	4404
Simpson Sandstone	4413
Arbuckle	4496 ✓

--- Figures Indicate Bottom of Formation ---

Surface Soil & Sand	200
Red Bed	480
Red Bed & Shale	690
Anhydrite	700
Shale & Shells	1450
Lime & Shale	3040
Lime	3210
Lime & Shale	3545
Lime	4011
Lime & Shale	4032
Cherty Lime	4047
Miss. Chert	4060
Chert & Lime	4094
Chert	4123
Lime	4154
Shale & Lime	4338 1/2
Cherty Dolo.	4347
Viola	4380 ✓
Lime & Shale	4428
Sand & Sandy Shale	4449
Sand & Shale	4500
Lime	4533

STATE OF KANSAS)
RUSSELL COUNTY) SS.

I hereby certify that the above information is correct to the best of my knowledge.

BENNETT & ROBERTS DRILLING COMPANY

By Russ Lake

Subscribed and sworn to before me this 24th day of July, 1956.

Clara Lummel
Notary Public

My Commission Expires 6/17/58

IVED
COMMISSIONER

PLUGGING
FILE SEC. 21 T. 27 R. 10W
BOOK PAGE 82 LINE 33

JUL 25 1956
CONSERVATION DIVISION
Wichita, Kansas