

STATE OF KANSAS
STATE CORPORATION COMMISSION


WELL PLUGGING RECORD

FORMATION PLUGGING RECORD

Strike out upper line when reporting plugging of formations.

Give All Information Completely
Make Required Affidavit
Mail or Deliver Report to:
Conservation Division
State Corporation Commission
800 Bifling Building
Wichita, Kansas

NORTH

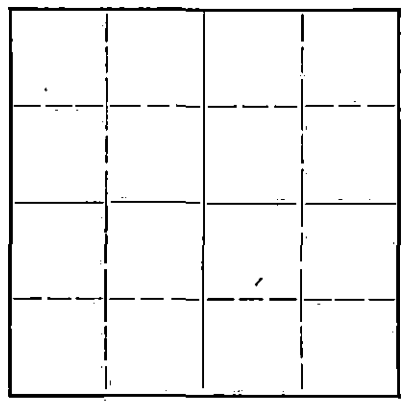

Locate well correctly on above Section Plat

Reno County, Sec. 3 Twp. 26S Rge. (E) 5(W)
Location as "NE1/4NW1/4SW1/4" or footage from lines 330' S of N Line & 330' W of
Lease Owner British American Oil Prod. Co. East Line.
Lease Name Breitenbach "A" Well No. 1
Office Address Philtower Bldg., Tulsa, Oklahoma
Character of Well (completed as Oil, Gas or Dry Hole) Dry Hole
Date well completed February 13 19 44
Application for plugging filed February 12 19 44
Application for plugging approved February 17 19 44
Plugging commenced February 13 19 44
Plugging completed February 14 19 44
Reason for abandonment of well or producing formation Dry hole.

If a producing well is abandoned, date of last production Dry hole 2-13-44 19
Was permission obtained from the Conservation Division or its agents before plugging was commenced? Yes


Name of Conservation Agent who supervised plugging of this well Ruel Durkee
Producing formation None Depth to top Bottom Total Depth of Well 4142 Feet
Show depth and thickness of all water, oil and gas formations.

OIL, GAS OR WATER RECORDS

CASING RECORD

Formation	Content	From	To	Size	Put In	Pulled Out
None	None			9 5/8"	345'	None, cemented to surface.


Describe in detail the manner in which the well was plugged, indicating where the mud fluid was placed and the method or methods used in introducing it into the hold. If cement or other plugs were used, state the character of same and depth placed, from feet to feet for each plug set.
Mud from 4142' to 340'
Wooden plug and 15 sacks of cement from 340' to 302'
Mud from 302' to 35'
10 sacks of cement from 35' to 6'. Welded plate over surface casing and cemented bottom of cellar with 5 sacks of cement.
6' to ground level filled in with surface dirt.

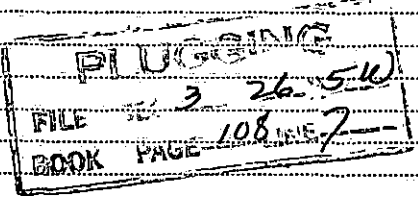

(If additional description is necessary, use BACK of this sheet)
Correspondence regarding this well should be addressed to British American Oil Producing Company
Address P.O. Box 57
Great Bend, Kansas

STATE OF Kansas, COUNTY OF Barton, ss.
P. T. Hayward. (employee of owner) or (owner or operator) of the above-described well,
being first duly sworn on oath, says: That I have knowledge of the facts, statements, and matters herein contained and the log of the above-described well as filed and that the same are true and correct. So help me God.

SUBSCRIBER AND SWORN to before me this 18th day of February 1944
My commission expires 2-19-44
Notary Public
Justin G. Boice

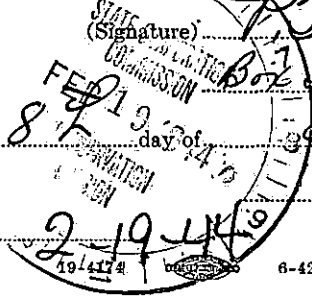

THE BRITISH-AMERICAN OIL PRODUCING COMPANY

WELL LOG

BREITENBACH "A" NO. 1

LOCATION: 330' from the North Line and 330' from the East Line of the NE/4 of the NE/4 of Section 3 - 26S - 5W, Reno County, Kansas.

Ground Elevation	1465'
Top Viola Lime	3973'
Top Arbuckle Lime	4087'
Total Depth	4138'
Drilling Commenced	12-27-43
Drilling Completed	2-13-44

CASING RECORD: 9-5/8" OD 36# casing cemented with 125 sacks at 341' G.L.

REMARKS: Well completed as a dry hole.

DRILLERS' LOG

<u>FROM</u>	<u>TO</u>	<u>FORMATION</u>	<u>FROM</u>	<u>TO</u>	<u>FORMATION</u>
0	10	Cellar	3633	3638	Shale
10	25	Surface Clay & Shells	3638	3645	Lime
25	60	Shale	3645	3664	Lime & Shale
60	130	Sand	3664	3672	Lime
130	695	Shale and shells	3672	3705	Lime & Shale
695	760	Anhydrite	3705	3707	Shale & Shells
760	830	Shale & Lime Shells	3707	3709	Chat
830	986	Shale & Broken Lime Shells	3709	3717	Lime & Chert
986	1130	Lime & Shale	3717	3721	Lime & Shale
1130	1234	Lime, broken	3721	3769	Lime
1234	1335	Lime & Shale	3769	3807	Lime & Shale
1335	1446	Lime, broken	3807	3835	Shale & Lime Shells
1446	1656	Lime Shells & Shale	3835	3897	Shale & Lime
1656	1790	Lime	3897	3927	Shale & Streaks of Lime
1790	1890	Shale & Lime Shells			
1890	2304	Lime & Shale	3927	3977	Shale & Lime. Top of Viola Lime.
2304	2405	Lime & Streaks of Shale			
2405	2700	Lime	3977	3980	Viola Lime
2700	2727	Sand	3980	3983	Cored Viola Lime
2727	2795	Lime; broken & Shale	3983	3994	Viola Lime
2795	3427	Lime	3994	4005	Simpson Shale
3427	3470	Shale & Lime Shells	4005	4035	Simpson Shale & Sand
3470	3507	Shale & Shells	4035	4056	Lime & Shale
3507	3535	Shale & Lime Shells	4056	4059	Lime
3535	3549	Shale	4059	4080	Shale & Lime
3549	3553	Chert	4080	4085	Lime & Sand
3553	3559	Chat	4085	4091	Shale & Lime. Top of Arbuckle Lime.
3559	3633	Lime			

3-9-44

FILE 3-26-54
 BOOK PAGE 108 LINE 7

<u>FROM</u>	<u>TO</u>	<u>FORMATION</u>
4091	4138	Lime
4138	4142	Arbuckle Lime
Total Depth	4142	
" "	4138	Corrected to Ground Level.

DRY HOLE - PLUGGED.

Stamp: Survey
MAY 1944
3-9-44

PLUGGING
FILE 3-26-54
BOOK PAGE 108 LINE 7