


WELL PLUGGING RECORD

Give All Information Completely
Make Required Affidavit
Mail or Deliver Report to:
Conservation Division
State Corporation Commission
211 No. Broadway
Wichita, Kansas

Reno County, Sec. 34 Twp. 26 Rge. 4W (E) (W)

Location as "NE/CNW/SW" or footage from lines SW SE NE
Lease Owner Osage Oil & Gas Co.
Lease Name Ast Well No. 1
Office Address 531 Petroleum Bldg., Wichita, Ks.
Character of Well (completed as Oil, Gas or Dry Hole) Dry
Date well completed 4/4/56 19
Application for plugging filed 4/3/56 19
Application for plugging approved 4/3/56 19
Plugging commenced 4/4/56 19
Plugging completed 4/4/56 19
Reason for abandonment of well or producing formation Dry

NORTH

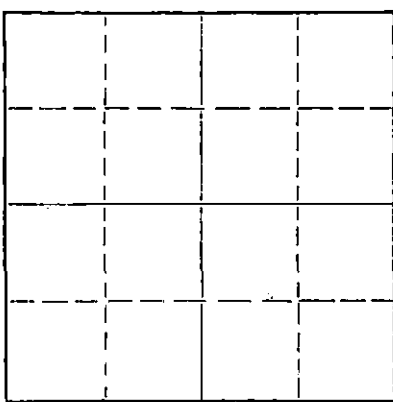

Locate well correctly on above Section Plat

If a producing well is abandoned, date of last production _____ 19____
Was permission obtained from the Conservation Division or its agents before plugging was commenced? yes

Name of Conservation Agent who supervised plugging of this well Ruel Durkee
Producing formation _____ Depth to top _____ Bottom _____ Total Depth of Well 4285 Feet
Show depth and thickness of all water, oil and gas formations.

OIL, GAS OR WATER RECORDS

CASING RECORD

FORMATION	CONTENT	FROM	TO	SIZE	PUT IN	PULLED OUT
				8 5/8	200	none

Describe in detail the manner in which the well was plugged, indicating where the mud fluid was placed and the method or methods used in introducing it into the hole. If cement or other plugs were used, state the character of same and depth placed, from _____ feet to _____ feet for each plug set.

PLUGGING RECORD

Filled with heavy mud from 4285 to 195'. Set wood plug using hulls and 15 sax cement through drill pipe. Filled with heavy mud from 175' to 30' using hulls set wooden plug with 5 sax cement to cellar zero. Job complete 6:30 am.

(If additional description is necessary, use BACK of this sheet)

Name of Plugging Contractor Trans Era Petroleum, Inc.
Address 420 W. Douglas Ave., Wichita, Kansas

STATE OF KANSAS, COUNTY OF RUSSELL, ss.
C. T. Honaker (employee of owner) or (owner or operator) of the above-described well, being first duly sworn on oath, says: That I have knowledge of the facts, statements, and matters herein contained and the log of the above-described well as filed and that the same are true and correct. So help me God.

(Signature) C. T. Honaker
(Address) _____

SUBSCRIBED AND SWORN TO before me this 6th day of April, 19 56

My commission expires 1-30-57

Margaret Cooper
STATE OF KANSAS
Notary Public.

PLUGGING
FILE SEC 34 T 26 R 4W
BOOK PAGE 51 LINE 45

APR 9 - 1956
CONSERVATION DIVISION
Wichita, Kansas

AST #1
 OSAGE OIL & GAS CO.
 Trans Era Petroleum, Inc. - Contr.

SW SE NE Sec. 34-26S-4W
 Reno County, Kansas

Elev: 1500 D.F.

Total Depth: 4285'

Comm: 3/13/56
 Comp: 4/4/56

Casings:

8 5/8 @ 200' w/150 sacks comm cement (2% Gel 1% CC)

FORMATION	DEPTH
Surface clay & sand	50
Shale	160
Red Rock & shale	200
Shale Black Sofe	265
Shale & shells	545
Salt - shale	725
Lime - shale	1000
Lime	1230
Lime & shale	1575
Shale - lime	2430
Lime	2645
Lime & shale	2795
Shale & shells	2845
Lime & shale	2865
Lime	3357
Shale & lime	3695
Miss.	3747
Cherty Lime	3780
Miss Lime & chert	3810
Lime & chert	3862
Miss Lime & chert	3887
Lime - chert	3898
Miss Lime	3969
Lime	4018
Miss Lime	4042
Lime & shale	4083
Shale	4145
Lime	4157
Shale & lime	4180
Lime	4285

Tops:		DEPTH
	Kansas City	2874
	Base K.C.	3352
	Miss.	3688
	Ip Viola	4140
	Top Arb.	4259

STATE OF KANSAS)
) ss:
 COUNTY OF RUSSELL)

I hereby certify that the above information is true and correct to the best of my knowledge.

C. P. Honaker

Subscribed and sworn to before me this 6th day of April, 1956.

4-9-56
 Notary Public

Margie Cooper
 Notary Public

My commission expires: 1-30-57.

PLUGGING
 FILE SEC 34 T 26 R 4W
 BOOK PAGE 51 LINE 45