


STATE OF KANSAS
STATE CORPORATION COMMISSION
Give All Information Completely
Make Required Affidavit
Mail or Deliver Report to:
Conservation Division
State Corporation Commission
800 Bitting Building
Wichita, Kansas

WELL PLUGGING RECORD

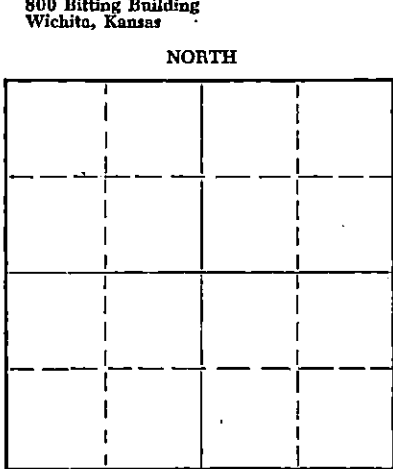

Locate well correctly on above Section Plat

Reno County, Sec. 30 Twp. 26 Rge. 4 (SE) (W)
Location as "NE/CNWxSWx" or footage from lines NE NE SE
Lease Owner McNeish & Galapp
Lease Name Lenhart Well No. 1
Office Address 528 State Bank Bldg., Winfield, Kansas
Character of Well (completed as Oil, Gas or Dry Hole) Dry Hole
Date well completed 5-19-56 19
Application for plugging filed 5-19-56 19
Application for plugging approved 5-19-56 19
Plugging commenced 5-19-56 19
Plugging completed 5-19-56 19
Reason for abandonment of well or producing formation

If a producing well is abandoned, date of last production 19
Was permission obtained from the Conservation Division or its agents before plugging was commenced? yes

Name of Conservation Agent who supervised plugging of this well Durkee
Producing formation Depth to top Bottom Total Depth of Well Feet
Show depth and thickness of all water, oil and gas formations.

OIL, GAS OR WATER RECORDS

CASING RECORD

FORMATION	CONTENT	FROM	TO	SIZE	PUT IN	PULLED OUT

Describe in detail the manner in which the well was plugged, indicating where the mud fluid was placed and the method or methods used in introducing it into the hole. If cement or other plugs were used, state the character of same and depth placed, from feet to feet for each plug set.
Mud from 4059 ft. to 250 ft.; 15 sacks cement; then mud to 35 ft.; cement from 35 ft. to 0 ft.

STATE OF KANSAS
JUN 2 1956
6-2-56
CONSERVATION DIVISION
Wichita, Kansas

(If additional description is necessary, use BACK of this sheet)
Name of Plugging Contractor Watson Drilling Co., Inc. (plugged by rotary rig)
Address 528 State Bank Bldg., Winfield, Kansas

STATE OF Kansas, COUNTY OF Cowley, ss.
Geo. T. McNeish (employee of owner) or (owner or operator) of the above-described well, being first duly sworn on oath, says: That I have knowledge of the facts, statements, and matters herein contained and the log of the above-described well as filed and that the same are true and correct. So help me God.

(Signature) Geo. T. McNeish
Winfield, Kansas
(Address)

SUBSCRIBED AND SWORN TO before me this 31st day of May, 19 56

My commission expires April 9, 1957

Grace Hill
Notary Public.

PLUGGING
FILE SEC 30 T 26 R 4W
BOOK PAGE 64 LINE 27

WELL LOG

Company: McNeish & Gralapp
Winfield, Kansas

Farm: LENHART #1
NE NE SE Sec. 30-26-4
RenO County, Kansas

Contractor: Watson Drilling Co., Inc.
Winfield, Kansas.

Comm: 4-30-56
Comp: 5-19-56

Casing Record: 270 ft. of 8 5/8"
surface csg. set with 250
sacks cement.

Surface clay	0	20
shale & lime	20	255
lime	255	258
shale	258	270
shale & shells	270	705
Anhydrite	705	730
shale & shells	730	740
shale & lime	740	1220
shale	1220	1240
lime & shale	1240	1280
lime	1280	1355
lime & shale	1355	1480
shale	1480	1525
shale & lime	1525	1595
shale & shells	1595	1955
shale & lime	1955	2330
lime	2330	2390
shale & lime	2390	2520
lime & shale	2520	2797
brown lime	2797	2824
Stalnaker sand	2824	2838
shale	2838	2843
Lansing	2843	2855
lime	2855	3497
lime & shale	3497	3587
lime	3587	3591
Conglomerate	3591	3611
Mississippi	3611	3840
lime & shale	3840	3883
lime	3883	3903
lime & shale	3903	3976
CORE #1	3976	3988
lime & shale	3988	4038
Viola	4038	4056
Simpson	4056	4059

T.O. D. 4059

DRY & PLUGGED

6-2-56

PLUGGING
 FILE SEC 30 T. 26 R. 4W
 BOOK PAGE 64 LINE 27