


WELL PLUGGING RECORD

Give All Information Completely
Make Required Affidavit
Mail or Deliver Report to:
Conservation Division
State Corporation Commission
212 No. Market
Wichita, Kansas

NORTH

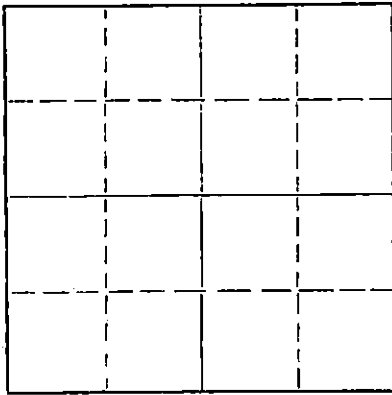

Locate well correctly on above
Section Plat

Reno County, Sec. 30 Twp. 26 Rge. (E) 4 (W)

Location as "NE/CNW/SW" or footage from lines NE NE NE

Lease Owner Santa-Fe Pipe & Supply, Inc.,

Lease Name Hilger=Cron Well No. 1

Office Address Box 562, Great Bend, Kansas

Character of Well (completed as Oil, Gas or Dry Hole) oil

Date well completed 19

Application for plugging filed February 20 19 68

Application for plugging approved February 20 19 68

Plugging commenced February 20 19 68

Plugging completed February 26 19 68

Reason for abandonment of well or producing formation depleted

If a producing well is abandoned, date of last production 19

Was permission obtained from the Conservation Division or its agents before plugging was commenced? yes

Name of Conservation Agent who supervised plugging of this well Gilbert Toman

Producing formation Depth to top Bottom Total Depth of Well 4050' Feet

Show depth and thickness of all water, oil and gas formations.

OIL, GAS OR WATER RECORDS

CASING RECORD

FORMATION	CONTENT	FROM	TO	SIZE	PUT IN	PULLED OUT
				8-5/8"	247'	none
				5-1/2"	4049'	3531.92'

Describe in detail the manner in which the well was plugged, indicating where the mud fluid was placed and the method or methods used in introducing it into the hole. If cement or other plugs were used, state the character of same and depth placed, from feet to feet for each plug set.

4050' - 3980' - plug
 3980' - 3940' - sand
 3940' - 3905' - 5 sacks cement
 3905' - 240' - mud
 240' - 230' - rock bridge
 230' - 170' - 20 sacks cement
 170' - 40' - mud
 40' - 30' - rock bridge
 30' - base - 10 sacks cement

RECEIVED
 STATE CORPORATION COMMISSION
 MAR 25 1968
 CONSERVATION DIVISION
 Wichita, Kansas
 3-25-68

(If additional description is necessary, use BACK of this sheet)

Name of Plugging Contractor Santa-Fe Pipe & Supply, Inc.,

Address Box 562, Great Bend, Kansas

STATE OF Kansas, COUNTY OF Barton, ss.
T. L. Nutt, (Employer of worker) or (owner or operator) of the above-described well, being first duly sworn on oath, says: That I have knowledge of the facts, statements, and matters herein contained and the log of the above-described well as filed and that the same are true and correct. So help me God.

(Signature) [Signature] Box 562, Great Bend, Kansas (Address)

SUBSCRIBED AND SWORN TO before me this 23 day of March 19 68

My commission expires July 31, 1970

[Signature] Notary Public.

DRILLING LOG

*Only Copy
R & W*

Company: Fleming & Woodman Drilling Co.
& Frank A. Oyster

Lease: Hilger-Cron - NE Corner 30-26S-4W, Reno County, Kansas.
Well: No. 1

Contractor: Fleming & Woodman Drilling Co.
Box 536 - Great Bend, Kansas.

Date Comm: 5-19-55
Date Compl: 6-6-55

T. D.: 4050 feet.

Casing: 247' 8-5/8" surface casing. 200 sq cm
4099 5/8" oil string, 100 sq cm
Figures Indicate Bottom of Formation

RECEIVED
STATE CORPORATION COMMISSION
FEB 20 1968
CONSERVATION DIVISION
Wichita, Kansas
2-20-68

0-48	Surface soil	3165-3190	Lime
105	Sand	3245	"
205	Shells & Shale	3260	"
247	" "	3270	"
635	" "	3300	Lime & Shale
820	" "	3345	" "
985	" "	3375	" "
1185	Lime and Shale	3430	" "
1295	" "	3490	" "
1425	" "	3545	" "
1615	" "	3574	" "
1815	" "	3594	Mississippi
1925	" "	3603	"
2135	" "	3625	"
2290	" "	3642	"
2365	" "	3663	"
2495	" "	3687	"
2600	" "	3713	"
2705	" "	3760	"
2810	" "	3787	"
2860	Lime	3806	"
2925	" "	3842	"
2980	" "	3864	"
3030	" "	3884	"
3070	" "	3944	Shale & Lime
3110	" "	3964	" "
3165	" "	3992	" "

Page 2 of two pages.

I certify the attached is a true and correct copy of the Driller's Log on the No. 1 Hilger-Cron well, NE Corner 30-26S-4W, Reno County, Kansas.

FLEMING & WOODMAN DRILLING COMPANY

By:

K. T. Woodman

Subscribed and sworn to before me this 9th day of June, 1955.

Evelyn V. North
Evelyn V. North, Notary Public

My commission expires December 22, 1958.

RECEIVED
STATE CORPORATION COMMISSION
FEB 20 1968
CONSERVATION DIVISION
Wichita, Kansas