15-155-00165-0000

STATE OF KANSAS
STATE CORPORATION COMMISSION

Give All Information Completely
Make Required Affidavit
Mail or Deliver Report to:
Conservation Division
State Corporation Commission
800 Bitting Building
Wichita, Kansas

# WELL PLUGGING RECORD

OR

# FORMATION PLUGGING RECORD

Strike out upper line when reporting plugging off formations.

Reno County. Sec. 31 Twp. 26S Rge. (E) 4 (W)

Location as "NE¼NW¼SW¼" or footage from lines 1650' fr SL & 330' fr EL of SE/4

Lease Owner Phillips Petroleum Company

Lease Name Eck Well No. 1

Office Address Bartlesville, Oklahoma

Character of Well (completed as Oil, Gas or Dry Hole) Dry Hole

Date well completed September 1, 1948 19

Application for plugging filed September 20, 1948 19

Application for plugging approved September 21, 1948 19

Plugging commenced September 22, 1948 19


Plugging completed September 27, 1948 19

Reason for abandonment of well or producing formation Dry Hole

If a producing well is abandoned, date of last production 19

Was permission obtained from the Conservation Division or its agents before plugging was commenced? Yes

NORTH

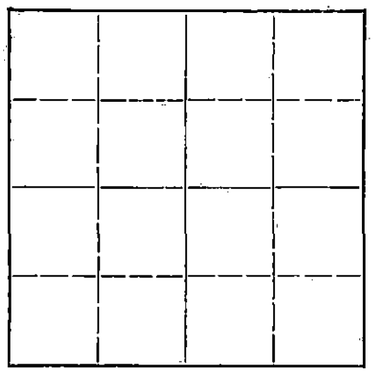

Locate well correctly on above Section Plat

Name of Conservation Agent who supervised plugging of this well Ruel Durkee

Producing formation Viola Depth to top 4021' Bottom Total Depth of Well 4036 Feet

Show depth and thickness of all water, oil and gas formations.

OIL, GAS OR WATER RECORDS — CASING RECORD

| Formation | Content | From | To | Size | Put In | Pulled Out |
|---|---|---|---|---|---|---|
| Heebner | | 2578' | | 8 5/8" | 347'9" | |
| Lansing-Kansas City | | 2831' | | | | |
| Mississippian | | 3611' | | 5 1/2" | 4039.09' | 2811'11" |
| Kinderhook | | 3893' | | | | |
| Misener | | 3967' | | | | |
| Viola | Oil | 4021' | 4036' | | | |

Describe in detail the manner in which the well was plugged, indicating where the mud fluid was placed and the method or methods used in introducing it into the hold. If cement or other plugs were used, state the character of same and depth placed, from feet to feet for each plug set.

Well had previously been plugged back with cement from Total Depth of 4036' to 3945'.
Filled with mud to 3253'. Shot off casing at 3100', 3050', 3000', 2950', 2900', 2880', 2840', and 2800'.
Filled with mud to 300' and ran 15 sacks of cement.
Filled with mud to 30' and ran 4 sacks of cement to base of cellar.
Plugging completed September 27, 1948.

(If additional description is necessary, use BACK of this sheet)

Correspondence regarding this well should be addressed to N. C. Mortimer

Address Box 779, Great Bend, Kansas

STATE OF Kansas, COUNTY OF Barton, ss.

A. L. Rhodes (employee of owner) or (owner or operator) of the above-described well, being first duly sworn on oath, says: That I have knowledge of the facts, statements, and matters herein contained and the log of the above-described well as filed and that the same are true and correct. So help me God.

(Signature) A. L. Rhodes

Box 779, Great Bend, Kansas
(Address)

SUBSCRIBED AND SWORN TO before me this 12th day of October, 1948

J. L. Marsh
Notary Public.

My commission expires March 27, 1950

21-6858-RS 2-47—6M

OCT 13 1948

10-13-48

PLUGGING
FILE SEC T R
BOOK PAGE LINE

15-155-00165-0000

Form No. 875

# Formation Record

Lease Eck Well No: 1

| FROM | TO | Formation | REMARKS |
|---|---|---|---|
| | 125 | Red rock and shale. | |
| 125 | 300 | Shale and shells. | |
| 300 | 365 | Gray clay and shells | |
| 365 | 400 | Shale and shells | |
| 400 | 1650 | Lime and shale | |
| 1650 | 2120 | Shale and shells | |
| 2120 | 2230 | Lime and shale | |
| 2230 | 2375 | Shale and shells | |
| 2375 | 2485 | Lime and shale | |
| 2485 | 2750 | Lime and shale | |
| 2750 | 2945 | Lime | |
| 2945 | 2970 | Lime and shale | |
| 2970 | 3285 | Lime | |
| 3285 | 3611 | Lime and shale | |
| 3611 | 3623 | Mississippi Chat | |
| 3623 | 3653 | Mississippi Chat | |
| 3653 | 3695 | Mississippi Chat and shale | |
| 3695 | 3723 | Lime and shale | |
| 3723 | 3754 | Mississippi Chat and lime | |
| 3754 | 3789 | Lime and shale | |
| 3789 | 3807 | Mississippi Chat and shale | |
| 3807 | 3868 | Shale and lime | |
| 3868 | 3905 | Shale | |
| 3905 | 4025 | Shale and lime | |
| 4025 | 4027 | Lime | |

STATE CORPORATION COMMISSION
SEP 21 1948
CONSERVATION DIVISION

9-21-48

PLUGGING
FILE SEC 31 T 26 R 4W
BOOK PAGE 57 LINE 31