

STATE OF KANSAS
STATE CORPORATION COMMISSION
Give Information Completely
Make Required Affidavit
Mail or Deliver Report to:
Conservation Division
State Corporation Commission
212 North Market, Insurance Bldg.
Wichita, Kansas

WELL PLUGGING RECORD

NORTH

Locate well correctly on above Section Plat

Reno County, Sec. 31 Twp. 26 Rge. 4W (E) (W)
Location as "NE/CNW/SW" or footage from lines NW SE SE
Lease Owner Halliburton Oil Producing Co.
Lease Name Haukup
Office Address Cameron Building, Oklahoma City, Oklahoma Well No. 1
Character of Well (completed as Oil, Gas or Dry Hole) Dry Hole
Date well completed 1/19 19.62
Application for plugging filed 1/19 19.62
Application for plugging approved 1/19 19.62
Plugging commenced 1/19 19.62
Plugging completed 1/19 19.62
Reason for abandonment of well or producing formation Dry Hole
If a producing well is abandoned, date of last production 19
Was permission obtained from the Conservation Division or its agents before plugging was commenced? yes

Name of Conservation Agent who supervised plugging of this well Fred Hampel
Producing formation Depth to top Bottom Total Depth of Well 4028 Feet
Show depth and thickness of all water, oil and gas formations.

OIL, GAS OR WATER RECORDS				CASING RECORD		
FORMATION	CONTENT	FROM	TO	SIZE	PUT IN	PULLED OUT
				8-5/8	163'	None

Describe in detail the manner in which the well was plugged, indicating where the mud fluid was placed and the method or methods used in introducing it into the hole. If cement or other plugs were used, state the character of same and depth placed, from feet to feet for each plug set.

Jetted pits filled hole with heavy mud
plug at 160' - 20 sacks cement
Mud to 40' - 10 sacks cement
2 sacks cement in rat hole

RECEIVED
STATE CORPORATION COMMISSION
FEB 1 1962
CONSERVATION DIVISION
Wichita, Kansas
2-12-62

(If additional description is necessary, use BACK of this sheet)
Name of Plugging Contractor Tomlinson-Kathol, Inc.
Address 414 Union Center, Wichita, Kansas

STATE OF Kansas, COUNTY OF Sedgwick, ss.
Warren E. Tomlinson (employee of owner) or (owner or operator) of the above-described well, being first duly sworn on oath, says: That I have knowledge of the facts, statements, and matters herein contained and the log of the above-described well as filed and that the same are true and correct. So help me God.

(Signature) Warren E. Tomlinson
414 Union Center, Wichita, Kansas
(Address)

SUBSCRIBED AND SWORN TO before me this 9th day of February, 1962
C. Esther Lamone
My commission expires 1/19/65 Notary Public.

DRILLERS LOG
HALLIBURTON OIL PRODUCING CO.
1 HAUKUP
NE SE SE, SEC. 31-26S-4W
RENO COUNTY, KANSAS

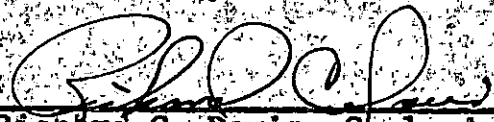
Contractor - Tomlinson-Kathol, Inc.

Commenced: 1/3/62
Completed: 1/18/62
Elevation: 1409 KB

From	To	Description	Remarks
0	100	Shale	
100	163	Shale & Shell	
163	410	Shale & Shells	164' 8-5/8" Surf. Csg. w/135
410	720	Shale	sacks cement
720	765	Anhydrite	
765	806	Shale	
806	945	Shale & Shells	
945	1100	Shale & Lime	
1100	1225	Shale	
1225	1575	Shale & Shell	
1575	2215	Sand & Lime	
2215	2335	Lime & Shale	
2335	2435	Lime	
2435	2485	Lime & Shale	
2485	2626	Shale & Lime - Sand	
2626	2838	Lime & Shale	
2838	2916	Lime	
2916	2980	Lime & Shale	
2980	3430	Lime	
3430	3485	Lime & Shale	
3485	3530	Lime	
3530	3595	Lime & Shale	
3595	3612	Mississippi Chat	
3612	3627	Chat	
3627	3644	Chat & Shale	
3644	3707	Chert & Shale	
3707	3735	Lime	
3735	3775	Lime & Shale	
3775	3805	Chert & Shale	
3805	3847	Lime	
3847	3878	Lime & Shale	
3878	3905	Shale & Lime	
3905	3955	Lime	
3955	3985	Shale & Lime	
3985	4011	Lime & Shale	
4011	4028	Lime	
4028		Rotary Total Depth	

RECEIVED
STATE COMMISSION
FEB 9 1962
CONSERVATION DIVISION

I certify to the best of my knowledge and belief, the above represents a true and accurate Driller's Log record of the captioned well.


Richard C. Davis, Geologist

STATE OF KANSAS)
COUNTY OF SEDWICK)

Subscribed and sworn to before me this 22nd day of January, 1962.


Esther Lamone, Notary Public