


STATE OF KANSAS
STATE CORPORATION COMMISSION
CONSERVATION DIVISION
WICHITA, KANSAS

FORM CP-4

WELL PLUGGING RECORD

New Address
245 North Water
Wichita, Kansas 67202

Reno County, Sec. 27 Twp. 26S Rge. 4W (E) (W)

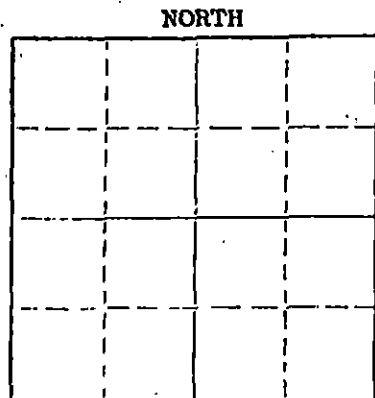

Locate well correctly on above Section Plat

Location as "NE/CNW&SW" or footage from lines C NW NW
Lease Owner: PICKRELL DRILLING COMPANY
Lease Name: AST "A"
Office Address: 205 LITWIN BLDG., Wichita, Ks. 67202
Character of Well (completed as Oil, Gas or Dry Hole) Dry Hole
Date well completed 6-3-76 19
Application for plugging filed 6-3-76 19
Application for plugging approved 6-3-76 19
Plugging commenced 6-3-76 19
Plugging completed 6-3-76 19
Reason for abandonment of well or producing formation Dry Hole

If a producing well is abandoned, date of last production 19
Was permission obtained from the Conservation Division or its agents before plugging was commenced? Yes

Name of Conservation Agent who supervised plugging of this well G. Russell Biberstein
Producing formation _____ Depth to top _____ Bottom _____ Total Depth of Well 4090
Show depth and thickness of all water, oil and gas formations.

OIL, GAS OR WATER RECORDS

CASING RECORD

FORMATION	CONTENT	FROM	TO	SIZE	PUT IN	PULLED OUT
				8 5/8	205	None

Describe in detail the manner in which the well was plugged, indicating where the mud fluid was placed and the method or methods used in introducing it into the hole. If cement or other plugs were used, state the character of same and depth placed, from _____ feet to _____ feet for each plug set.

35 sacks at 200'
15 sacks at 40'
5 sacks in Rat Hole Comp. 7AM 6-3-76

STATE CORPORATION COMMISSION
RECEIVED
JUN 14 1976
CONSERVATION DIVISION
Wichita, Kansas

Name of Plugging Contractor: PICKRELL DRILLING COMPANY
Address: 205 LITWIN BLDG., WICHITA, KS. 67202

STATE OF Kansas COUNTY OF Sedgwick ss.
C. W. Sebitts (employee of owner) or (owner or operator) of the above-described

well, being first duly sworn on oath, says: That I have knowledge of the facts, statements, and matters herein contained and the log of the above-described well as filed and that the same are true and correct. So help me God

(Signature) C. W. Sebitts
205 Litwin Bldg., Wichita, Ks. 67202
(Address)

Subscribed and sworn to before me this 10 day of June 1976

My commission expires _____
Jo Ann Sarver Notary Public.



ROTARY DRILLING LOG

COMPANY: PICKRELL DRILLING COMPANY
205 LITWIN BLDG.
WICHITA, Kansas 67202
LOCATION: AST "A" #1
C NW NW 27-26S-4W
Reno County, Kansas

Rotary Drilling Commenced 5-22-76
Rotary Drilling Completed 6-3-76

CONTRACTOR: **PICKRELL DRILLING COMPANY**
Wichita, Kansas

CASING RECORD: 8 5/8" surface casing set at 205' with 140 sacks. Comp. 5-23-76 12:15AM

LOG

(Figures indicate bottom of formation — measurements from top of rotary bushing.)

Red Rock & Shale	210
Lime & Shale	840
Lime & Shale	1160
Lime & Shale	1325
Lime & Shale	1525
Shale & Lime	1640
Shale & Lime	1925
Shale & Lime	2170
Shale & Lime	2365
Lime & Shale	2550
Lime & Shale	2730
Lime & Shale	2865
Lime	2960
Lime	3014
Lime & Shale	3105
Lime & Shale	3185
Lime & Shale	3207
Lime & Shale	3225
Lime & Shale	3245
Lime	3265
Lime	3345
Lime	3430
Lime	3500
Lime & Shale	3615
Lime & Shale	3652
Lime	3695
Lime	3785
Lime	3855
Lime	3903
Lime & Shale	3955
Lime	4025
Lime & Shale	4047
Lime & Shale	4065
Lime & Shale	4090

RECEIVED
STATE CORPORATION COMMISSION
6-14-76
JUN 14 1976
CONSERVATION DIVISION
Wichita, Kansas

The undersigned, C. W. Sebitts, Attorney-in-Fact for PICKRELL DRILLING COMPANY, hereby certifies in behalf of said Company, that the above is a true and correct log of the formation encountered in drilling the above well as reflected by the Daily Drilling Reports.

PICKRELL DRILLING COMPANY
By [Signature]
Attorney-in-Fact
C. W. Sebitts

STATE OF KANSAS }
COUNTY OF SEDGWICK } ss.:

On this 10 day of June, 19 76, before me the undersigned, a Notary Public, in and for the County and State aforesaid, personally appeared C. W. Sebitts, to me known to be the identical person who subscribed the name of PICKRELL DRILLING COMPANY to the foregoing instrument as its Attorney-in-Fact and acknowledged to me that he executed the same as his free and voluntary act and deed, and as the free and voluntary act and deed of such company, for the uses and purposes therein set forth.

Given under my hand and seal of office the day and year last above written.

My commission expires: _____

[Signature]
Notary Public
Jo Ann Sarver

