


STATE OF KANSAS
STATE CORPORATION COMMISSION

Give All Information Completely
Make Required Affidavit
Mail or Deliver Report to:
Conservation Division
State Corporation Commission
212 North Market, Insurance Bldg.
Wichita, Kansas

WELL PLUGGING RECORD

NORTH

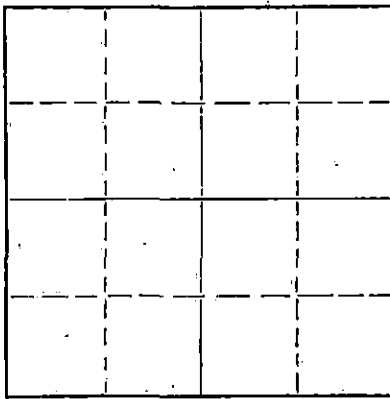

Locate well correctly on above
Section Plot

Reno County, Sec. 22 Twp. 26 Rge. 4 (E) (W)
Location as "NE/CNW/SW" or footage from lines SW SW SE
Lease Owner ~~Schmitz~~ Shawver-Armour, Inc.
Lease Name Schmitz Well No. 1
Office Address 817 Central Bldg. Wichita, Kansas
Character of Well (completed as Oil, Gas or Dry Hole) Dry hole
Date well completed April 13, 19 60
Application for plugging filed April 13, 19 60
Application for plugging approved April 13, 19 60
Plugging commenced April 13, 19 60
Plugging completed April 13, 19 60
Reason for abandonment of well or producing formation Dry hole

If a producing well is abandoned, date of last production 19
Was permission obtained from the Conservation Division or its agents before plugging was commenced? Yes

Name of Conservation Agent who supervised plugging of this well Fred W. Hampel
Producing formation Depth to top Bottom Total Depth of Well 4206 Feet
Show depth and thickness of all water, oil and gas formations.

OIL, GAS OR WATER RECORDS

CASING RECORD

FORMATION	CONTENT	FROM	TO	SIZE	PUT IN	PULLED OUT
Surface	Water	-0-	192	8 5/8"	192'	None

Describe in detail the manner in which the well was plugged, indicating where the mud fluid was placed and the method or methods used in introducing it into the hole. If cement or other plugs were used, state the character of same and depth placed, from feet to feet for each plug set.

Heavy mud to 190'

#1 Plug 190' Howco Plug & 1/4 sx Halls

15 sx cement in thru drill pipe

Heavy mud to 35'

#1 Plug 35' Howco Plug & 1/4 sx Halls

10 sx cement in mixed wet.

Bridge rat hole @ 6 ft. & 2 sx in it.

RECEIVED
STATE CORPORATION COMMISSION
3-25-60
APR 25 1960

CONSERVATION DIVISION
Wichita, Kansas

(If additional description is necessary, use BACK of this sheet)

Name of Plugging Contractor Shawver-Armour, Inc.
Address 817 Central Bldg., Wichita, Kansas

STATE OF KANSAS COUNTY OF SEDGWICK, ss.
James M. Armour (employee of owner) or (owner or operator) of the above-described

well, being first duly sworn on oath, says: That I have knowledge of the facts, statements, and matters herein contained and the log of the above-described well as filed and that the same are true and correct. So help me God.

(Signature)

James M. Armour

817 Central Bldg., Wichita, Kansas

(Address)

SUBSCRIBED AND SWORN to before me this 13th day of April, 19 60

My commission expires Dec. 29, 1963

Marjorie Hall

Notary Public.

DRILLER'S LOGFARM NAME: Schmitz # 1LOCATION: SW SW SE Sec. 22-26-4W
Reno County, KansasCONTRACTOR: Shawver-Armour, Inc.ELEVATION: 1492 K. B.OWNER: Shawver-Armour, Inc.COMMENCED:COMPLETED: April 13, 1960CASING RECORD: 192' 8 5/8" 155 sx cement
4 sx CCFORMATION:TOPS:

Surface Soil & Gravel	40
Red Rock	200
Gray Shale	675
Anhydrite	730
Lime & Shale	1420
Shale & Lime Shells	1695
Shale & Lime Streaks	1975
Shale & Lime	2345
Kansas City Lime	3340
Lime & Shale	3679
Mississippian Lime &	
Dolomite & Chert	3783
Mississippian	4003
Lime	4008
Kinderhook Shale	4099
Viola Lime	4113
Simpson	4139
Simpson Sand	4198
Simpson 4210	4206

Brown Lime	2820
Lansing - K. C.	2854
Mississippian	3660
Kinderhook Shale	4008
Viola	4099
Simpson Sand	4113
Rotary Total Depth	4206

RECEIVED
STATE CORPORATION COMMISSION

APR 25 1960
3-25-60
CONSERVATION DIVISION
Wichita, Kansas

STATE OF KANSAS)

SEDGWICK COUNTY)

I, James M. Armour, do hereby certify that the above log is a true and correct copy of the above captioned well as shown on the daily drilling reports.

SHAWVER, ARMOUR, INC.

BY James M. Armour
James M. Armour

Subscribed and sworn to before me this
13th day of April, 1960

My commission expires Dec. 29th, 1963

Maryjorie Hall
Maryjorie Hall, Notary Public