

WELL PLUGGING RECORD


FORMATION PLUGGING RECORD

Strike out upper line when reporting plugging off formations.

STATE OF KANSAS STATE CORPORATION COMMISSION

Give All Information Completely Make Required Affidavit Mail or Deliver Report to: Conservation Division State Corporation Commission 800 Bittling Building Wichita, Kansas

NORTH

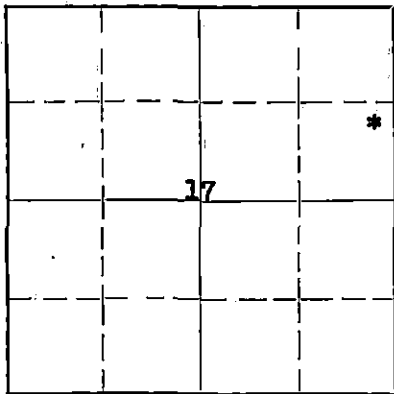

Locate well correctly on above Section Plat

Location as "NE 1/4 NW 1/4 SW 1/4" or footage from lines NE 1/4 SE 1/4 NE 1/4 Reno County. Sec. 17. Twp. 26S Rge. (E) 4 (W) Lease Owner Magnolia Petroleum Company Lease Name M. Thome Well No. 3 Office Address Box 888, Ellinwood, Kansas Character of Well (Completed as Oil, Gas or Dry Hole) Dry Hole - 11-10-37 Date, well completed 11-10-37 193 Application for plugging filed 10-2-41 193 Application for plugging approved 10-3-41 193 Plugging Commenced 10-8-41 193 Plugging Completed 10-15-41 193 Reason for abandonment of well or producing formation Dry Hole If a producing well is abandoned, date of last production 193 Was permission obtained from the Conservation Division or its agents before plugging was commenced? yes

Name of Conservation Agent who supervised plugging of this well Ruel Durkee, McPherson, Kansas Producing formation None Depth to top Bottom Total Depth of Well 4033 Feet. Show depth and thickness of all water, oil and gas formations.


OIL, GAS OR WATER RECORDS

CASING RECORD

Table with 7 columns: Formation, Content, From, To, Size, Put In, Pulled Out. Rows include Top Chat (Dry, 3915-4032, 13" OD, 182, none), Misener & Sylvan (Dry, 3985-4032, 7" OD, 4010, 2805'), and Viola Lime (42 Bbl. water, no oil-per hr., 4032-4033).

Describe in detail the manner in which the well was plugged, indicating where the mud fluid was placed and the method or methods used in introducing it into the hole. If cement or other plugs were used, state the character of same and depth placed, from feet to feet for each plug set.

In November, 1937 at time this well was completed as a dry hole we dumped 8 sacks of cement in hole which filled up from 4033 to 3993. The following work was done now: Filled hole with heavy mud from 3993 to 3615' Dumped 6 sax cement with dump bailer 3615 to 3585' Ripped 7" OD casing off at 2805 and pulled out. Filled with heavy mud from 3585 to 182' Dumped 20 sax cement with dump bailer 182 to 156' Filled with heavy mud from 156 to 19' Dumped 10 sax cement from 19 to 6' or bottom of cellar.

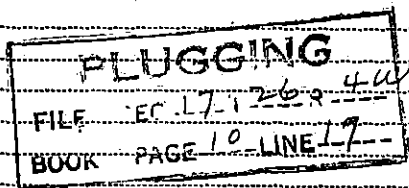

(If additional description is necessary, use BACK of this sheet)

Correspondence regarding this well should be addressed to John F. Conley, District Superintendent Address Box 888, Ellinwood, Kansas


STATE OF KANSAS, COUNTY OF BARTON, SS. John F. Conley (employee of owner) or (owner or operator) of the above-described well, being first duly sworn on oath, says: That I have knowledge of the facts, statements, and matters herein contained and the log of the above-described well as filed and that the same are true and correct. So help me God.

(Signature) [Signature]

Box 888, Ellinwood, Kansas (Address)

SUBSCRIBED AND SWORN TO before me this 21 day of October, 1941

My commission expires October 13, 1945

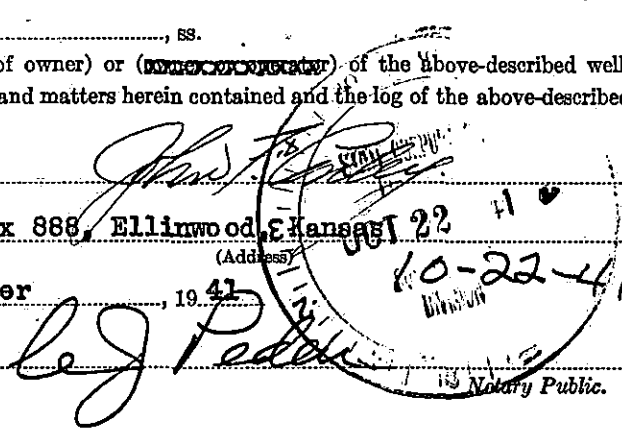

Casing Record

Magnolia Petroleum Company
 M. Thome #3
 NE/4 SE/4 NE/4 17-26-4W.
 Reno County, Kansas

Drig. Comm. 10-16-37
 Drig. Comp. 11-10-37

13"OD 40# Lapweld - 182'
 7"OD 24# Seamless -4010'

cellar	0	8
red rock	8	130
shale & shells	130	185
13"OD casing set at 182' cemented 200 Sax		
shale	185	415
salt	415	700
shale & shells	700	975
shale & lime	975	1510
shale	1510	1700
shale & shells	1700	2800
lime	2800	3465
shale, lime & shells	3465	3610
shale	3610	3615
Top Chat	3615	
chat	3615	3650
lime & chat	3615	3650
lime	3650	3770
shale	3770	3890
shale	3890	3900
shale & lime	3900	3935
shale	3935	4010
Top Misner & Sylvan	3985	
7"OD casing set at 4010 cemented 450 sax		

Standardized

shale	4010	4032
Top Viola Lime	4032	4033
cored 4012-4033		
TD - SLM	4033	

Well made 42 bbl. water and no oil
 per hour after 2 acid treatments.

Has been standing idle since date of completion.

INDEXING
 FILE 17 26-4W
 BOOK PAGE 10 NE 17

